


# T12S. R6W. WM.

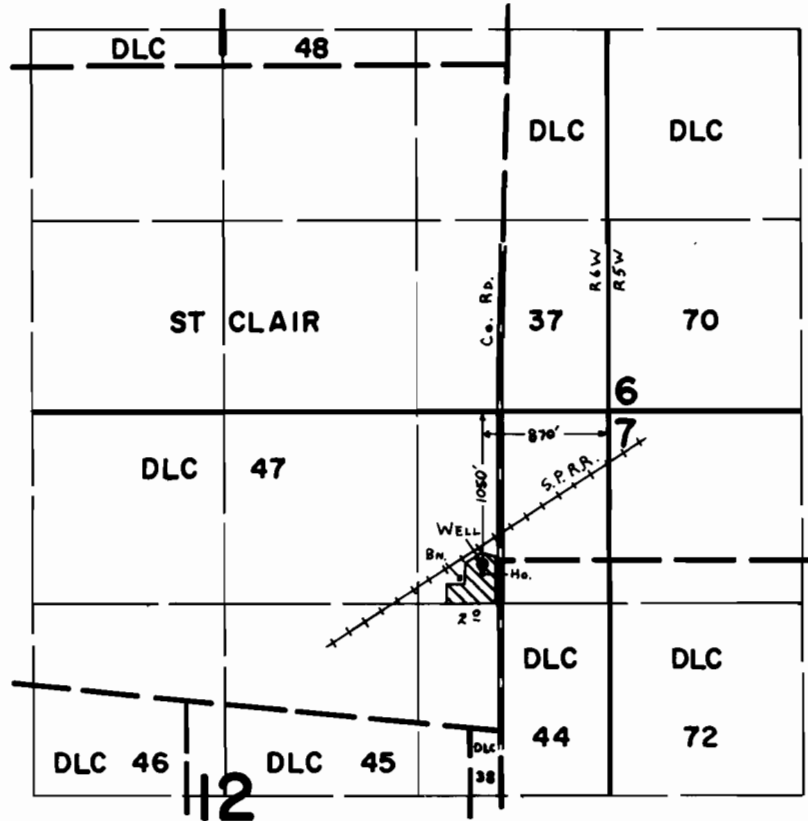

## FINAL PROOF SURVEY UNDER

Application No. G-6290 Permit No. G-5919  
IN NAME OF

ELIZABETH JEANNETTE GREEN

Surveyed May 2 1979, by C. L. HUGHES