


T13 & 14S. R7W. WM.

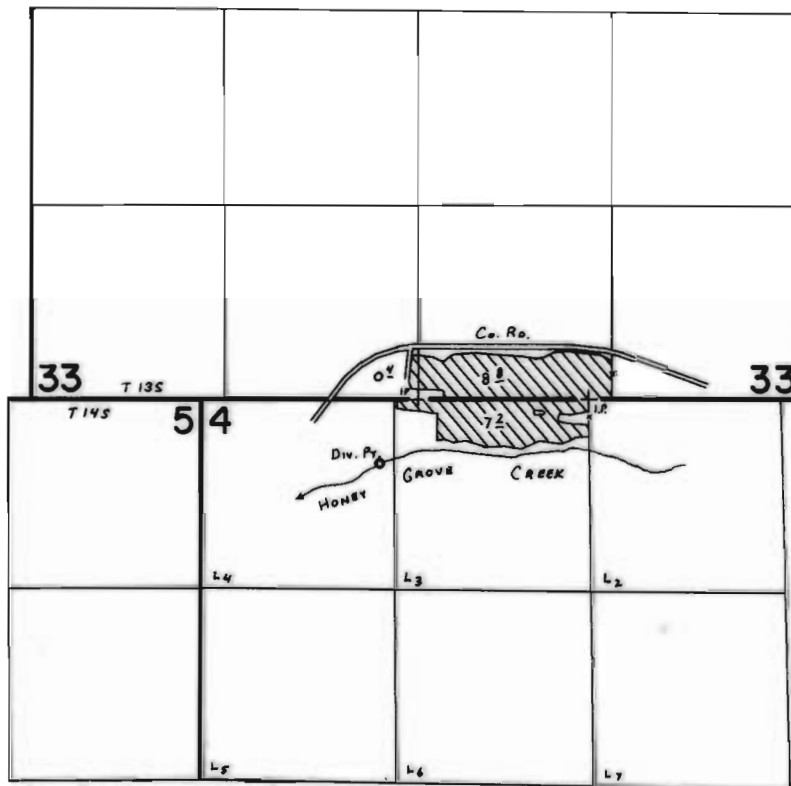

Div. PT. Loc: 440' S. & 1440' W. fr. N. 1/4 COR SEC. 4

FINAL PROOF SURVEY
UNDER

Application No. 50845. Permit No. 38389.....
IN NAME OF

GARY F. GREEN

Surveyed Aug. 16, 1979, by C. L. HUGHES.....