


T.5S. R.1E. W.M.

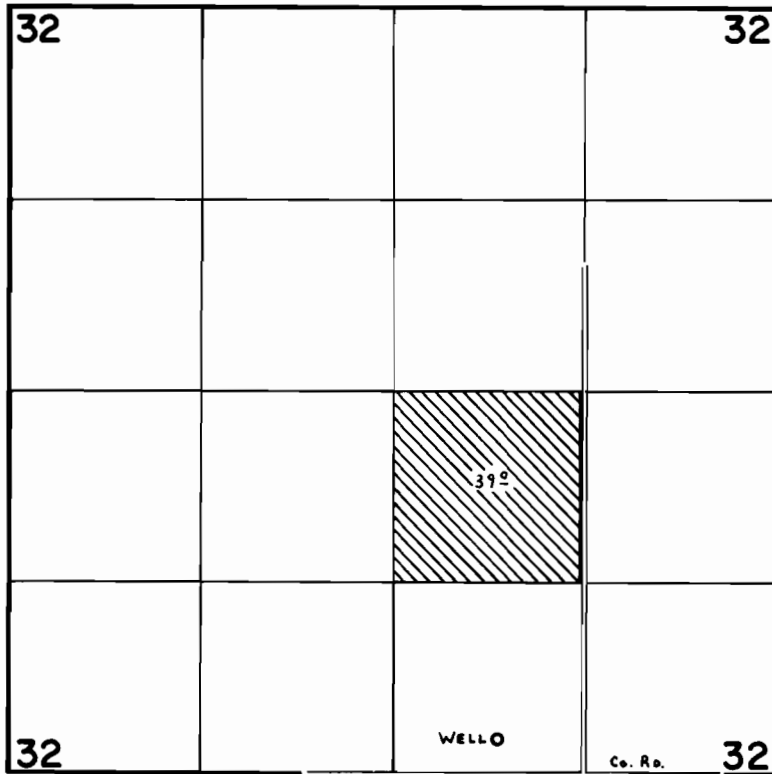

WELL LOC: 230' N. & 600' W. fr. S.E. COR. of SW 1/4 SE 1/4 Sec. 32.

FINAL PROOF SURVEY
UNDER

Application No. ~~G-8866~~ Permit No. ~~G-8219~~...
IN NAME OF

BRUCE & MARGARETE LANDSEM

Surveyed Oct. 12, 1979, by C. L. HUGHES...