


# T.4S.,R.1E.,&R.1W.,W.M.

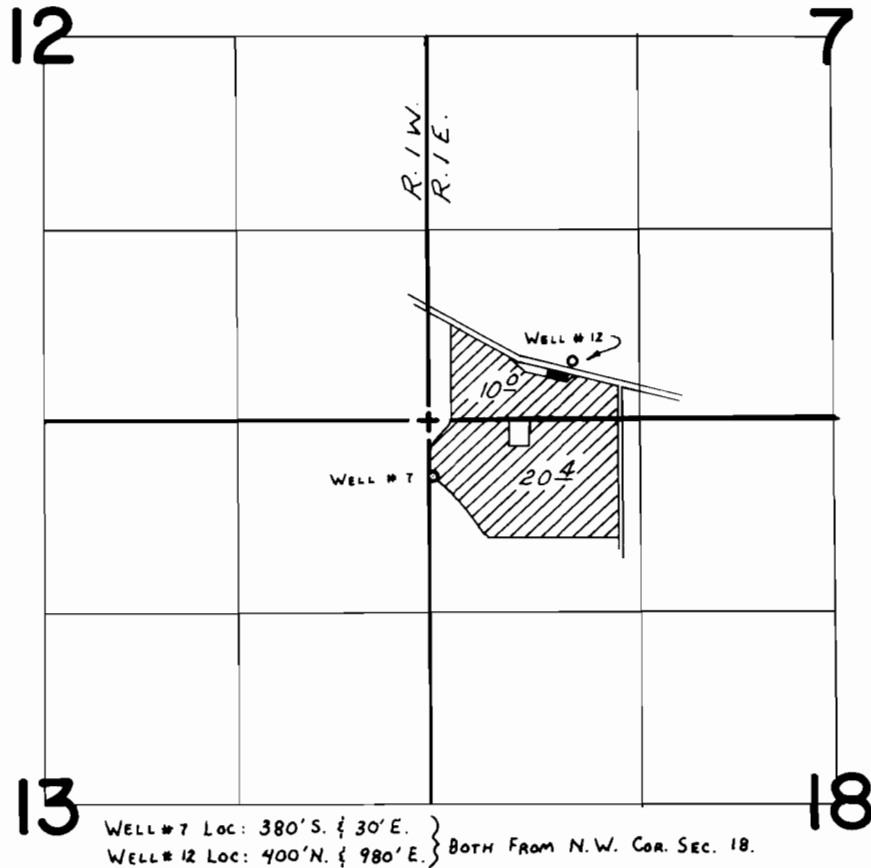

## FINAL PROOF SURVEY UNDER

Application No. G-7005 Permit No. G-6507  
G-7172 G-6611 (Supplemental)  
IN NAME OF

Weyerhaeuser Co.

Surveyed July 29, 1977, by A.C. Brown  
April 27, 1979 C.L. HUGHES

DFN-3LL-164