


T.4S. R.2E. W.M.

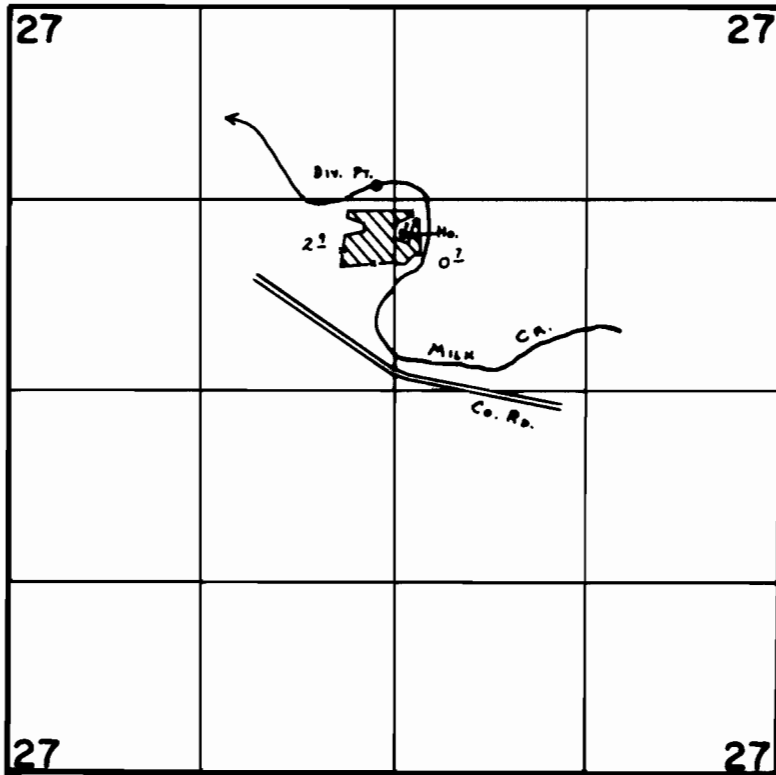

Div. Pt. Loc: 1410' N. & 120' W. fr. C. 1/4 Cor. Sec. 27.

FINAL PROOF SURVEY
UNDER

Application No. 53609 Permit No. 40103.....
IN NAME OF

HAROLD L. CHAPIN.....

Surveyed Oct. 10 1979, by C. L. HUGHES.....