T.4S. R.2E. W.M.

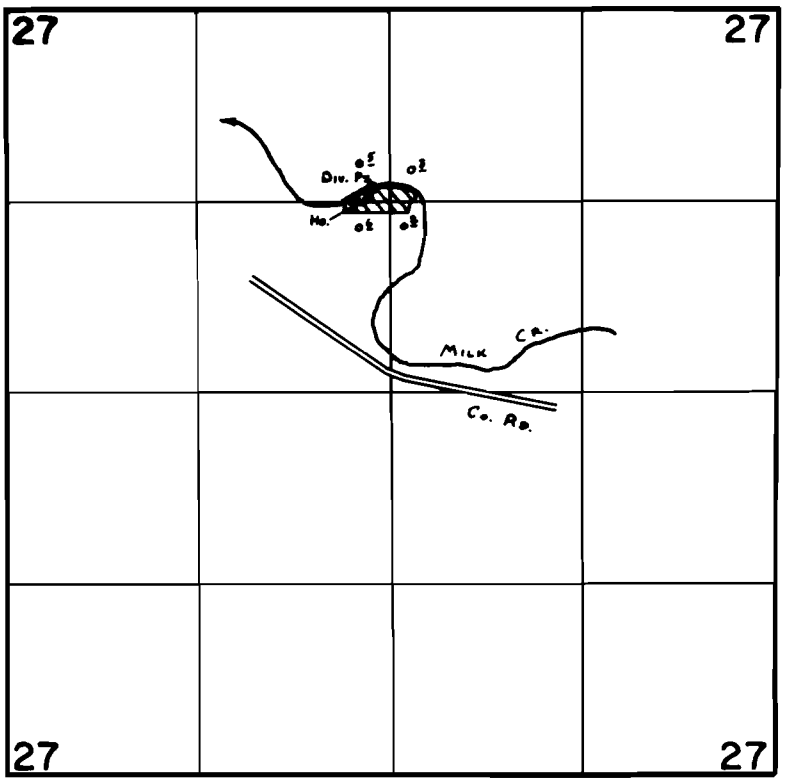

Div. Pt. Loc: 1410'N. & 120' W. fr. C. ¼ Cor. Sec. 27.

FINAL PROOF SURVEY
UNDER

Application No. 53320 Permit No. 39563
IN NAME OF

ERNEST CHAPIN

Surveyed Oct. 10 1979, by C. L. HUGHES

PTS-1979-L1
DFK-3LL-59