T.28S., R.5W., W.M.

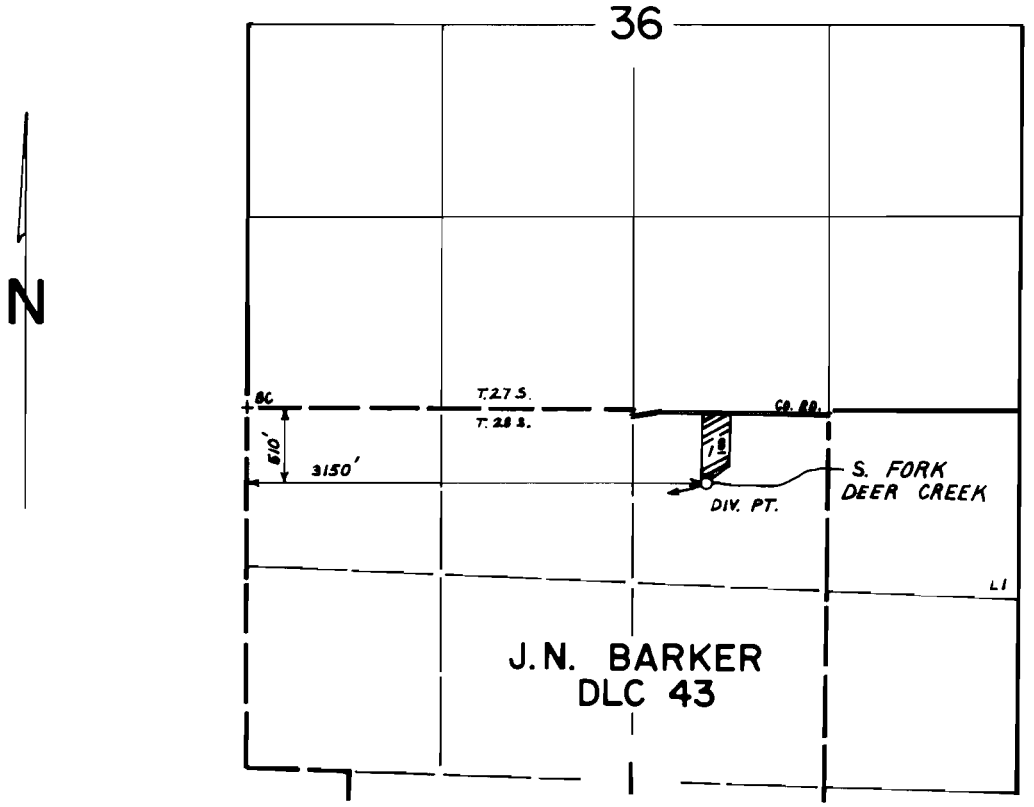

SCALE: 4" = 1 mile

FINAL PROOF SURVEY
UNDER

Application No. 51189 Permit No. 38681
IN NAME OF

JOHANNA KELLER

Surveyed APR. 14 19.80, by J.S. DONALDSON
JULY 2, 1984 L. CASHION

BTR-3HH-130 LEC