


T.29S. R.5W. W.M.

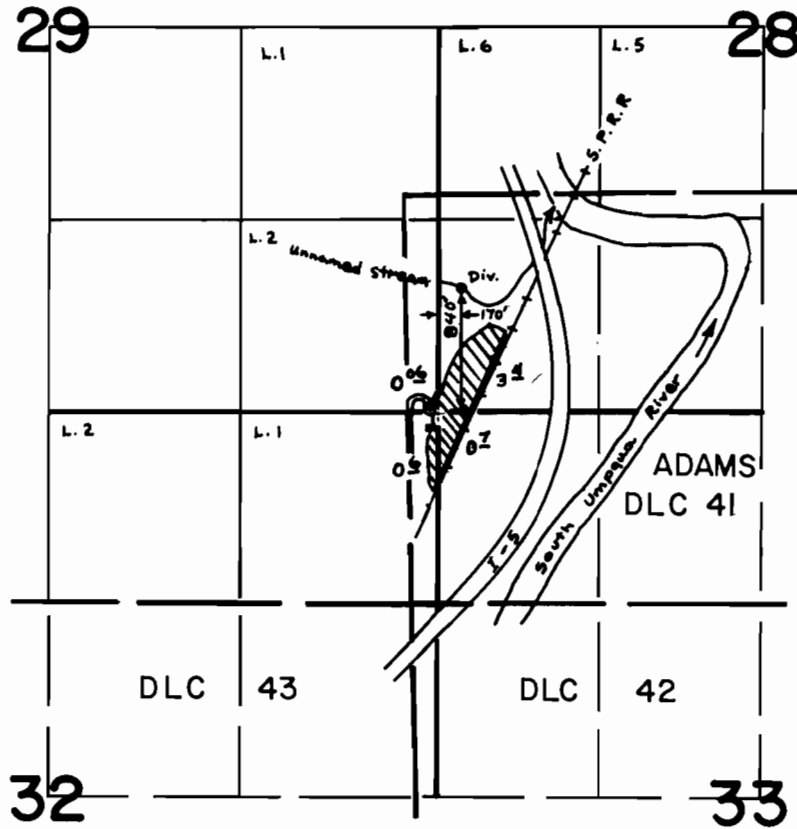

Scale: 4" = 1 mile

FINAL PROOF SURVEY
UNDER

Application No. 43392 Permit No. 32446
IN NAME OF

Edwin T. and Shirley E. Bacin

Surveyed Oct. 25, 1979, by S. Donaldson