


T. 32 S., R. 6 W., W.M.

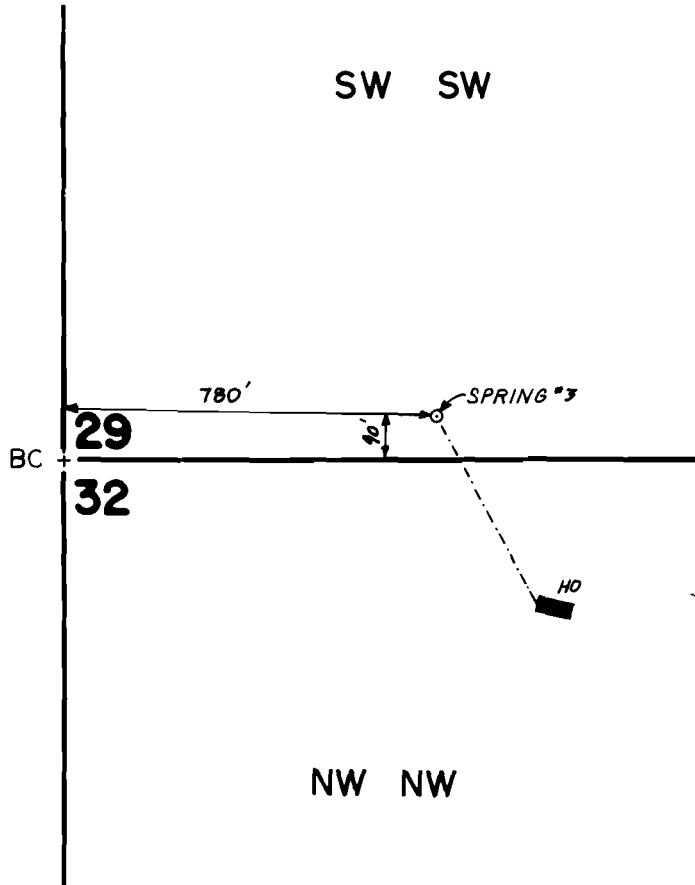

SCALE: 1" = 400'

FINAL PROOF SURVEY
UNDER

Application No. .61491... Permit No. .45682.....
IN NAME OF

.....LAURENCE H. FREEMAN.....

Surveyed AUG.....14 19.84, by *L.E. Cashion*.....