


T. 27S., R. 5W., W.M.

SEC. 19

NWNW

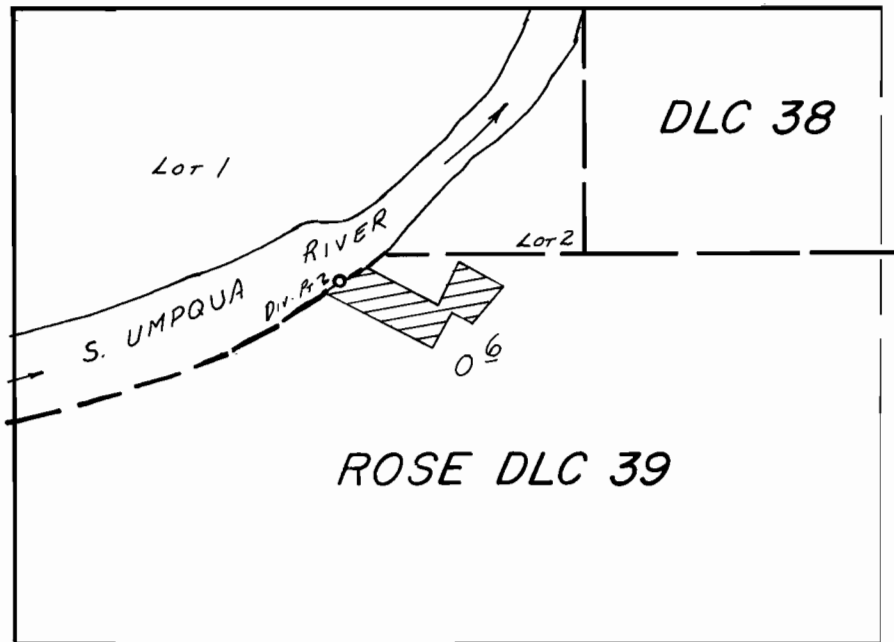

Div. Pt. Loc.: 55' S of 1690' W. FROM SE COR. Lot 2

SCALE: 1" = 400'

FINAL PROOF SURVEY
UNDER

Application No. 55071..... Permit No. 41296.....
IN NAME OF

..... FRED HOFFSTETTER

Surveyed MAR. 19... 1980., by J.S. DONALDSON