


# T9S. R27E. WM.

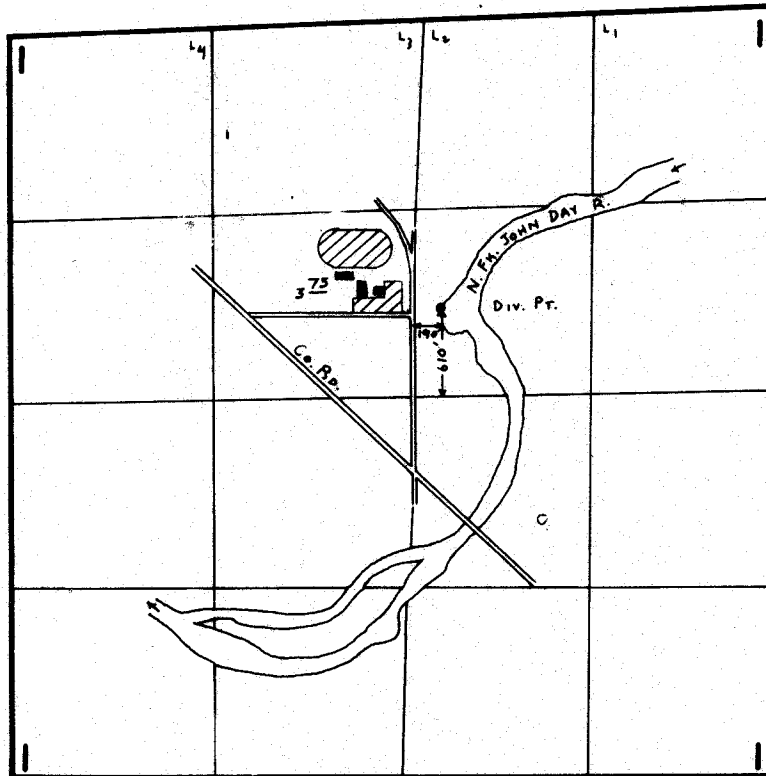

## FINAL PROOF SURVEY UNDER

Application No. 57751... Permit No. 43456.....  
IN NAME OF

**MONUMENT SCHOOL DIST. #8**

Surveyed July 12, 1979, by S. C. BROWN.....