


T.40S., R.1E., W.M.

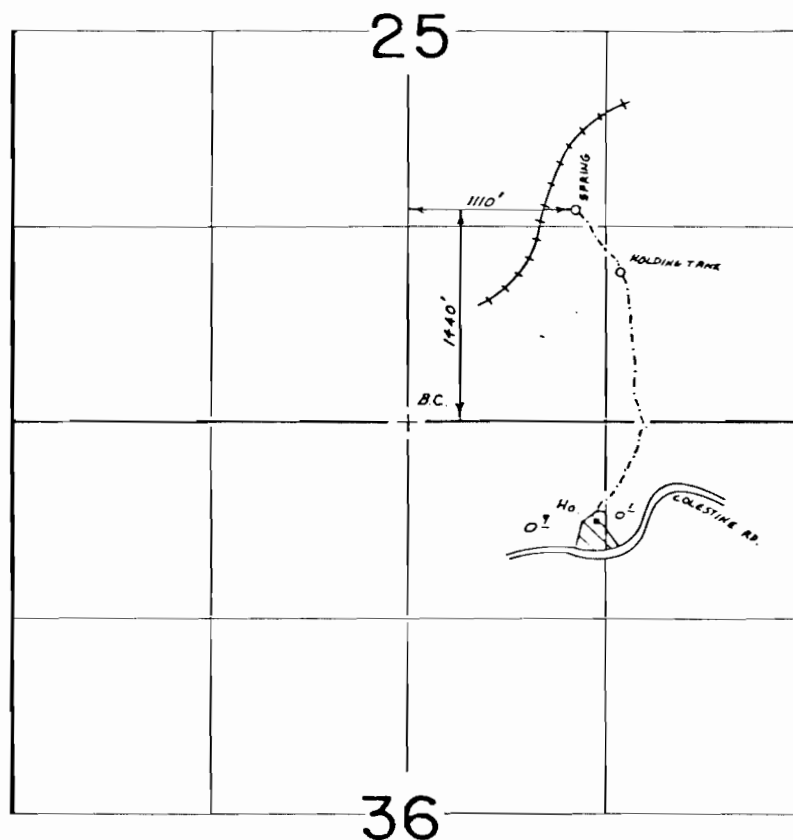

[REDACTED] SURVEY
UNDER

67333 48153
Application No. 53241.. Permit No. 39509.....
IN NAME OF
JACK D. & JINEEN McWHERTER
Surveyed Sept. 30, 1983, by B.S. JAMES.....

Scale 4" = 1 Mile

179-134L