


T. 37 S., R. 7 W., W. M.

SEC. 2

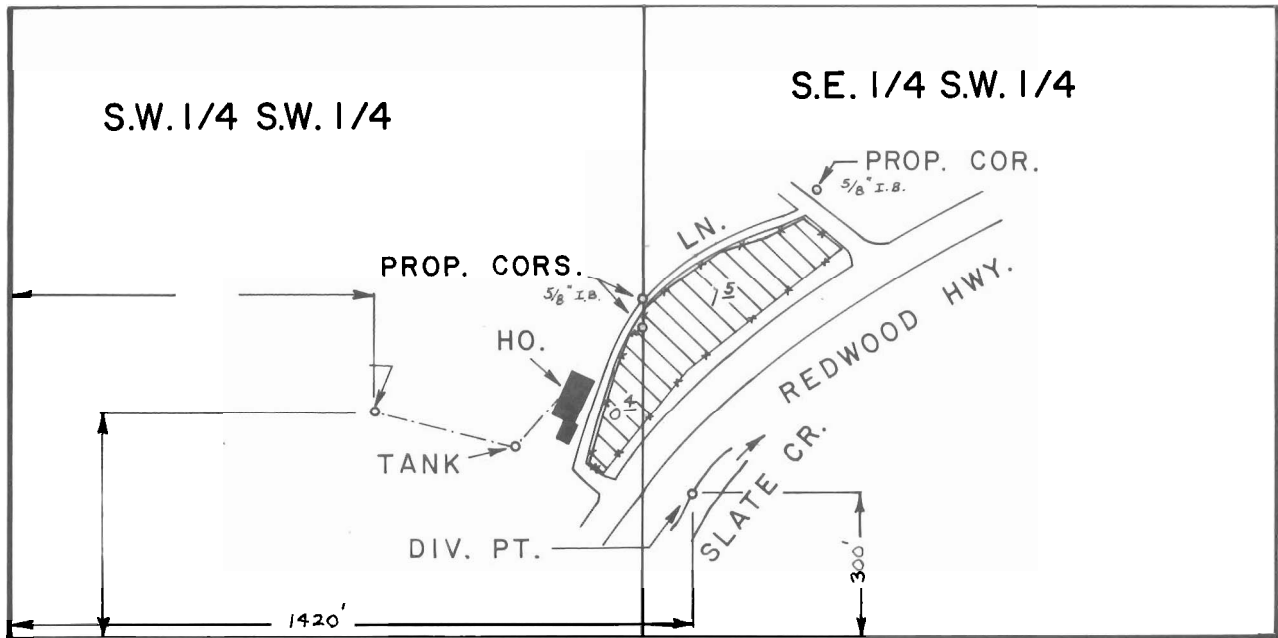

SCALE: 1" = 400 FT.

FINAL PROOF SURVEY
UNDER

Application No. 49551 Permit No. 36775
IN NAME OF

..... WILLIAM J. F. CARL L. HICKS

Surveyed APR. 12 1979 by B. SUND

D.H.M.
P.T.S. - 1979-14-A