


T.36 S., R.7W., W.M.

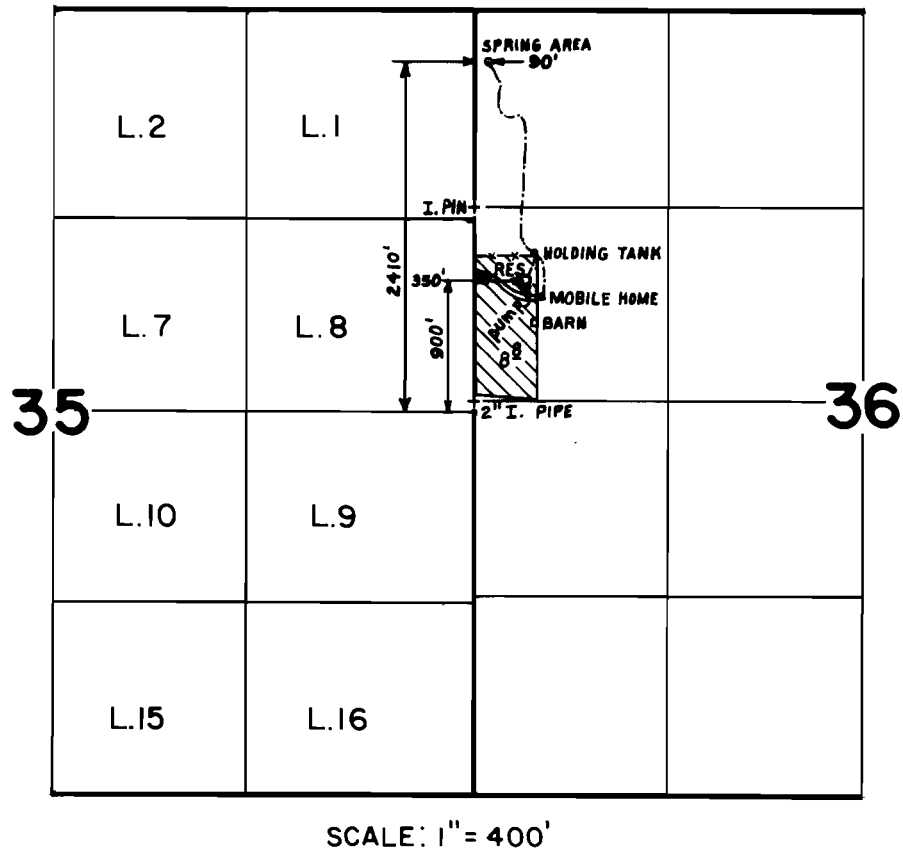

**FINAL PROOF SURVEY**  
UNDER

R-52278                      R-6296  
Application No. 52279      Permit No. 39340  
IN NAME OF

**CHARLES H. NEWCOMER & MELVYN G. HAUGEN**

Surveyed FEB. 7 19 84, by B. S. JAMES