


T.36 S., R.7W., W.M.

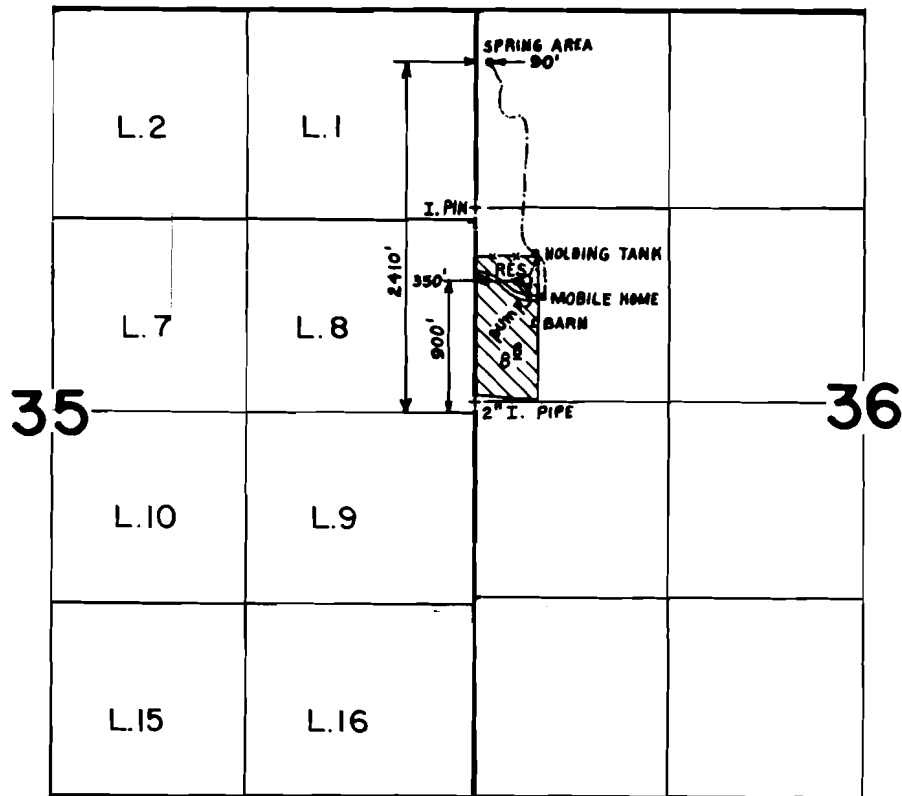

SCALE: 1" = 400'

**FINAL PROOF SURVEY**  
UNDER

R-52278      R-6296  
Application No. 52279      Permit No. 39340  
IN NAME OF

CHARLES H. NEWCOMER & MELVYN G. HAUGEN

Surveyed FEB. 7, 1984, by B. S. JAMES