


G-8431
T8512
52616

T.26S. R.18E. W.M.

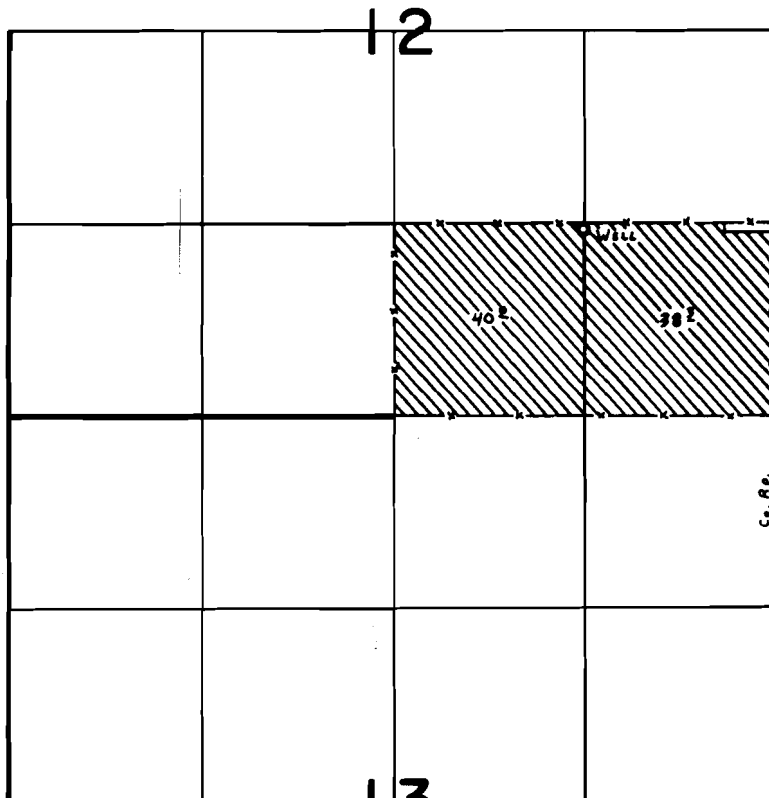

Well Loc: 1270' N. & 1330' W. fr. S.E. Cor. Sec. 12.

FINAL PROOF SURVEY
UNDER

Application No. G-9069 Permit No. G-8431...
IN NAME OF

.....LEONARD M. CHERRY.....

Surveyed Aug. 25, 1979, by C. L. HUGHES...