T.26S.,R.14E.,W.M.

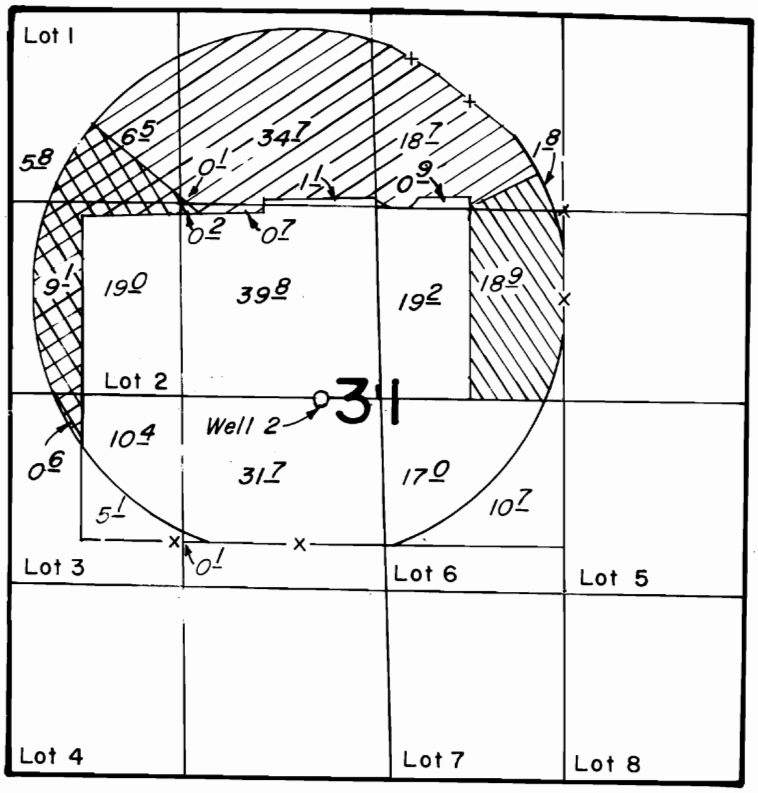

Well Loc.: 2600' S., & 2900' W., from the NE corner Section 31

SCALE: 4" = 1 MILE

FINAL PROOF SURVEY

UNDER

TRANSFER NOS. T-5363 & T-5364

Application No. G-9288 G-11072 Permit No. G-8709 G-10227

IN NAME OF

MICHAEL W. MATTIS

Surveyed July 27 19.83, by L. M. TOLL

Oct. 12 1984, by P. PAGTER

PTS 1983-2 Sec 44 Prp