


T.25S.,R.15E.,W.M.

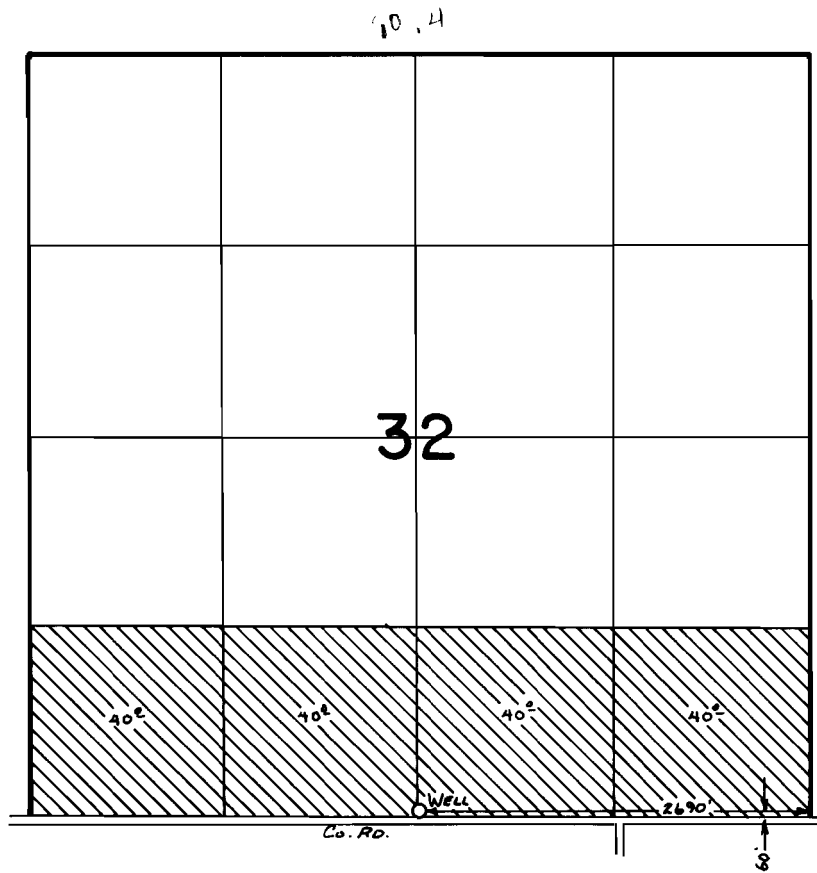

FINAL PROOF SURVEY
UNDER

Application No. G:9632. Permit No. G:8983.....
IN NAME OF

...MAURICE...L...&...HAZEL...I...WARD

Surveyed Oct. 21... 19.83., by L. M. TOLL.....