G 7842
52621

T.27S.,R.15E.,W.M.

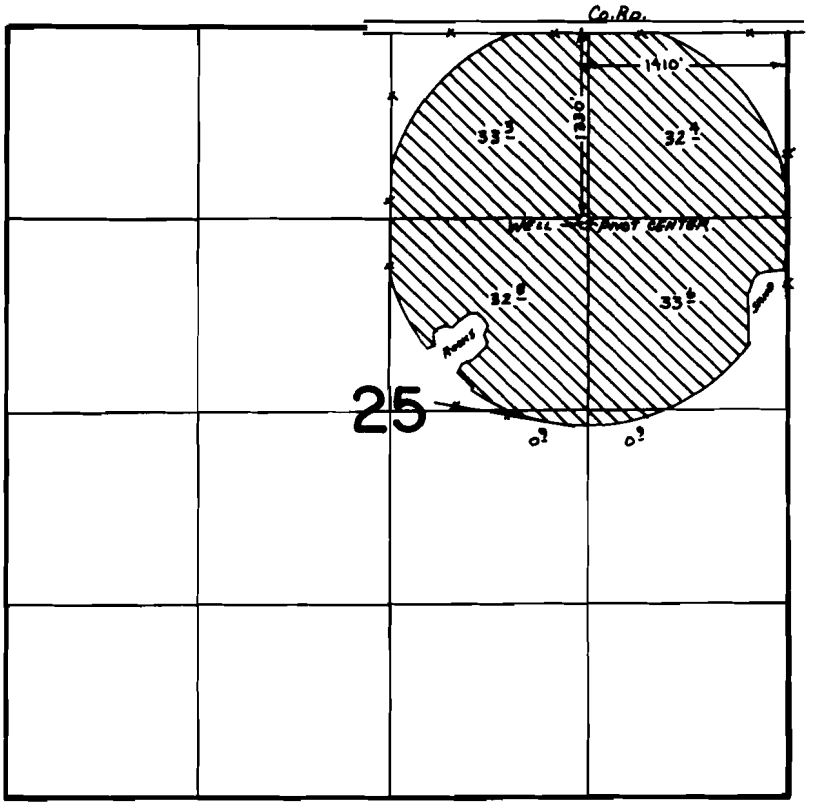

FINAL PROOF SURVEY
UNDER

Application No. G-8445 Permit No. G-7842
IN NAME OF

DARREL G. BOWEN

Surveyed July 26, 1983, by L.M. TOLL

PTS 1983-2