


G 8678  
52622

# T.26S.,R.14E.,W.M.

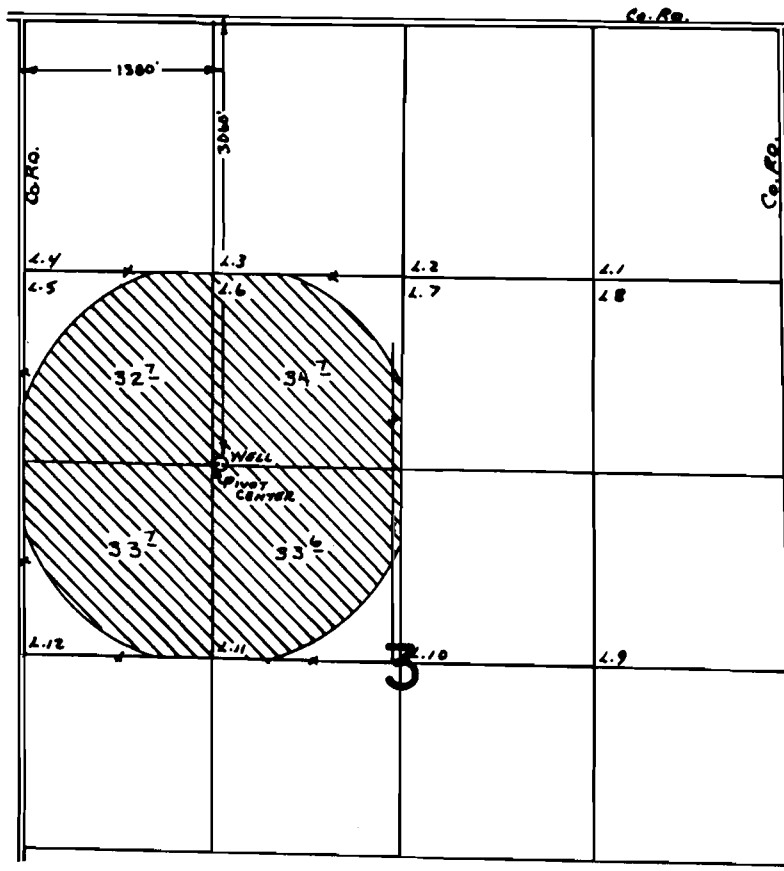

## FINAL PROOF SURVEY UNDER

Application No. G:9272. Permit No. G:8678....  
IN NAME OF

.....FLOYD & VENITA BRANCH.....

Surveyed July.27... 19.83., by L.M. IOLL.....