


G7484
52623
T9673

T.25S.,R.14E.,W.M.

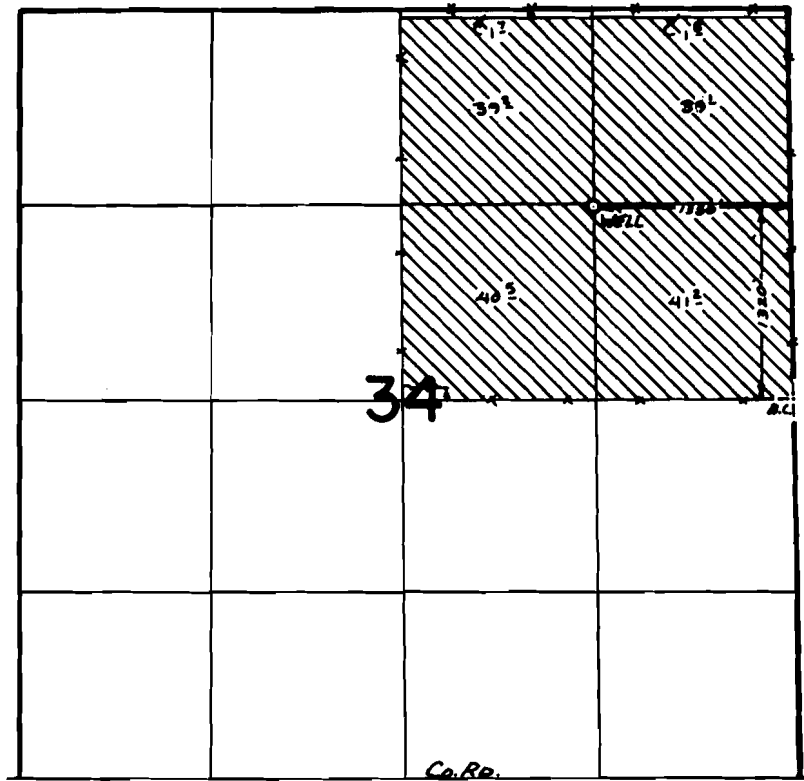

FINAL PROOF SURVEY UNDER

Application No. G-8099 Permit No. G-7484....
IN NAME OF

CHARLES TOMPKINS.....

Surveyed Oct. 19... 1983., by L. M. TOLL.....