


G7510
52624

T.26S.,R.14E.,W.M.

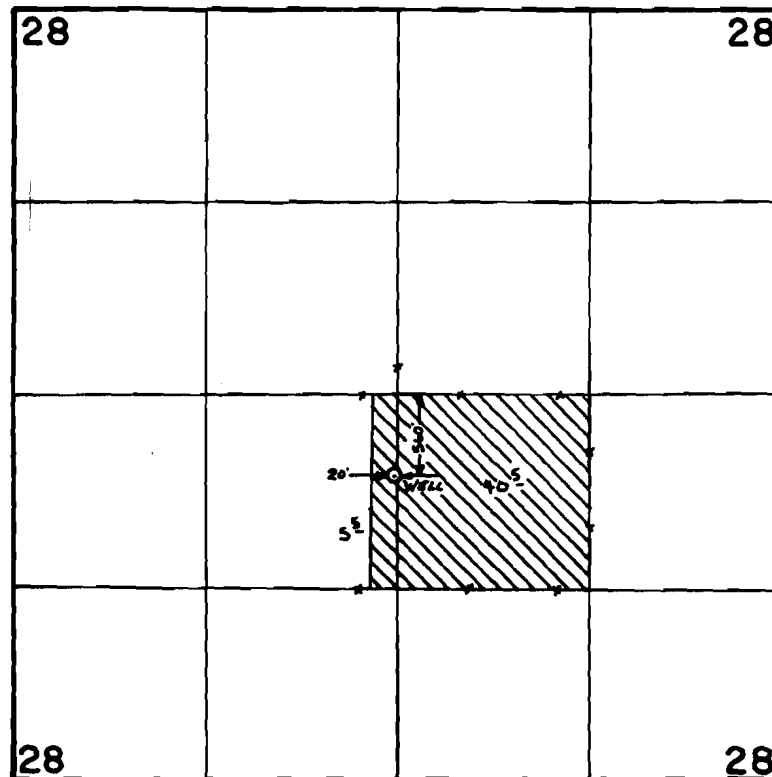

FINAL PROOF SURVEY
UNDER

Application No. .G:8139.. Permit No. .G:7510.....
IN NAME OF

...WILLIAM...L...&...FLOY...O...SMITH

Surveyed July..26.. 19.83., by ...L...M...TOLL.....