


G9314
52425

T.27S., R.17E., W.M.

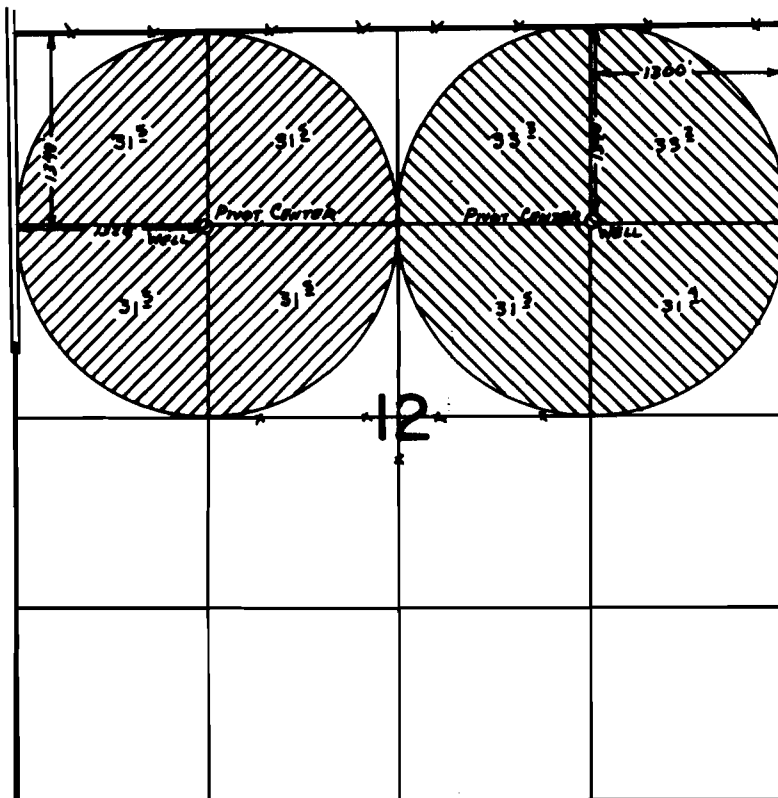

FINAL PROOF SURVEY
UNDER

G-10211 G-9314
Application No. G-10212. Permit No. G-9568. 
IN NAME OF

..... LARRY GRASSMAN

Surveyed Oct. 18, 1983, by L. M. TOLL