
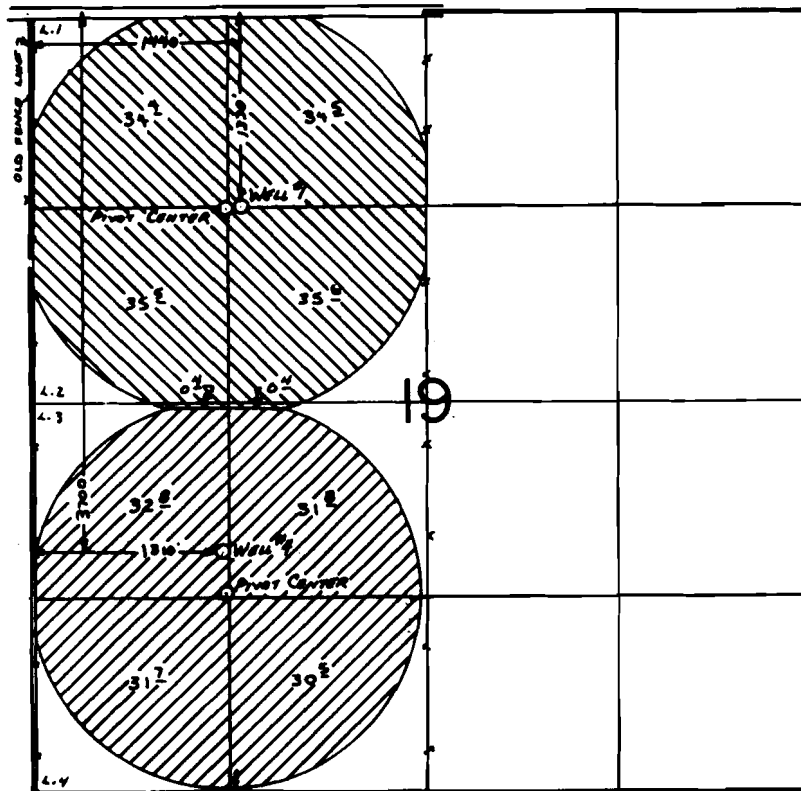
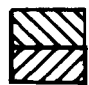


G9348
52624

T.25S.,R.15E.,W.M.

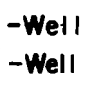

 -Well No. 1
 -Well No. 4

FINAL PROOF SURVEY UNDER

Application No. G:10291, Permit No. G:9348....
IN NAME OF

JOHN & NORMA FLAMING.....

Surveyed Oct. 19... 1983., by L.M. TOLL.....