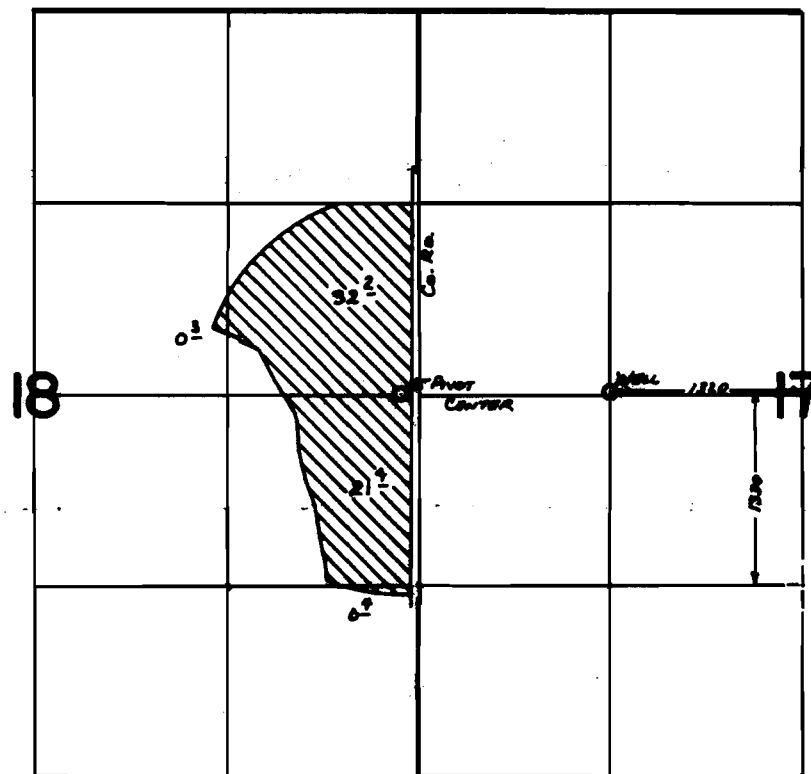


G9598

52627

T.25S.,R.18E.,W.M.

**FINAL PROOF SURVEY**
UNDERApplication No. 8-10407, Permit No. 8-2522.....
IN NAME OF

.....JAMES M. McDONALD.....

Surveyed July 21, 1983, by J. M. TOLL.....