


G 9062
T 1384
52630

T.25S.,R.14E.,W.M.

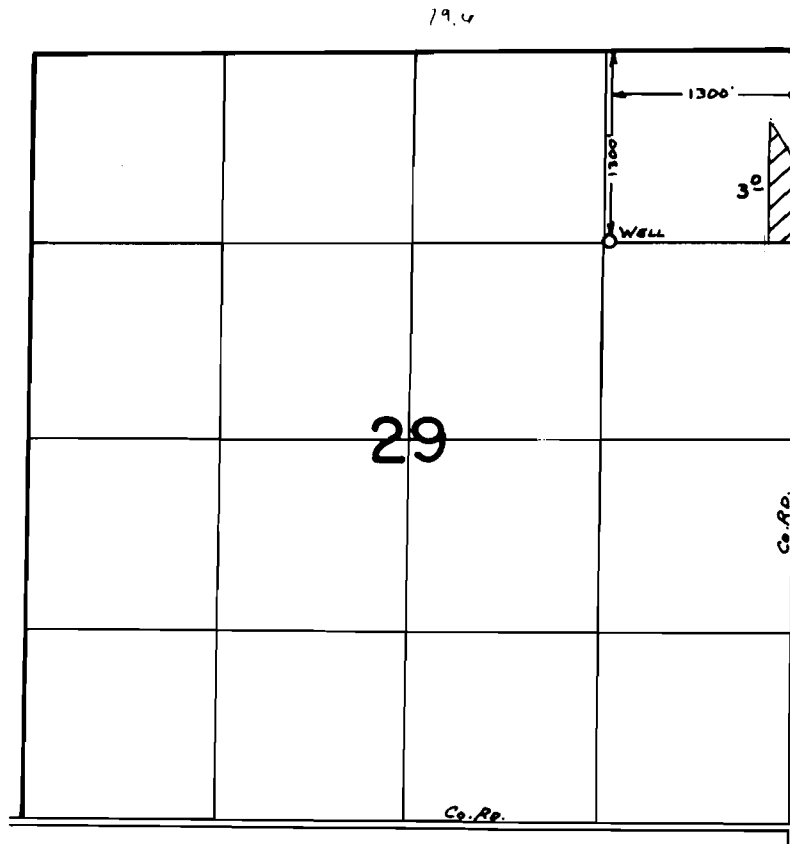

FINAL PROOF SURVEY
UNDER

Application No. G-9787. Permit No. G-9062.....
IN NAME OF

BANFIELD VETERINARY HOSPITAL, INC.

Surveyed Oct. 18, 1983, by L. M. TOLL.....

PTS 1983-Y
CHS-1KK-154