


G 8246

52632

T. 27 S., R. 17 E., W. M.

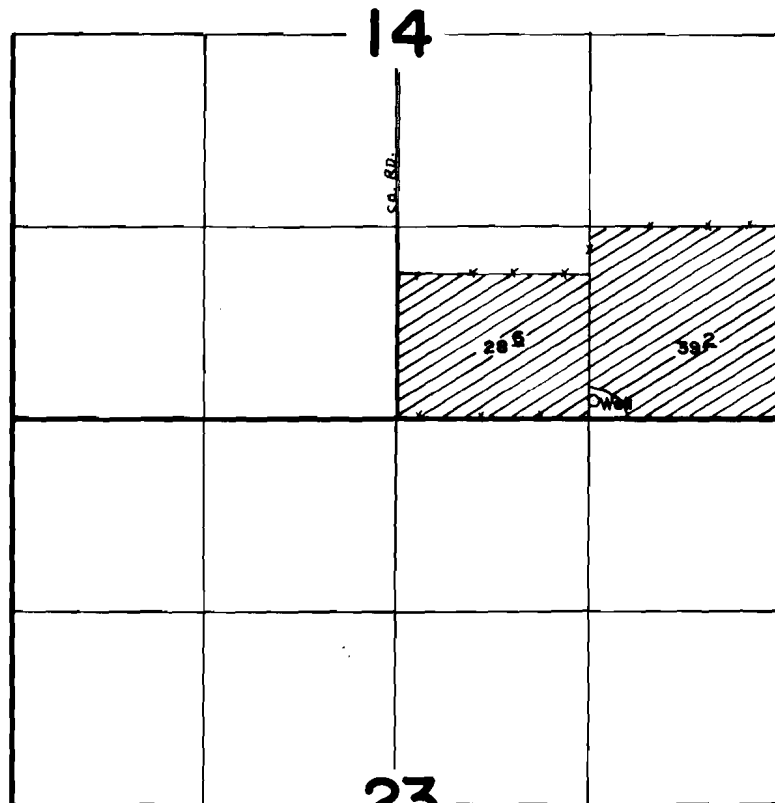

Well Loc.: 120' N. & 1300' W. from the SE Cor. Sec. 14.

FINAL PROOF SURVEY
UNDER

Application No. ~~G-8744~~ Permit No. ~~G-8246~~....
IN NAME OF

.....**GOLDEN.....RULE.....FARMS**.....

Surveyed OCT...13.. 1983., by ~~L...TOLL~~.....

PTS-1983 Y

JMW