


G9509
52634

T.25S.,R.13E.,W.M.

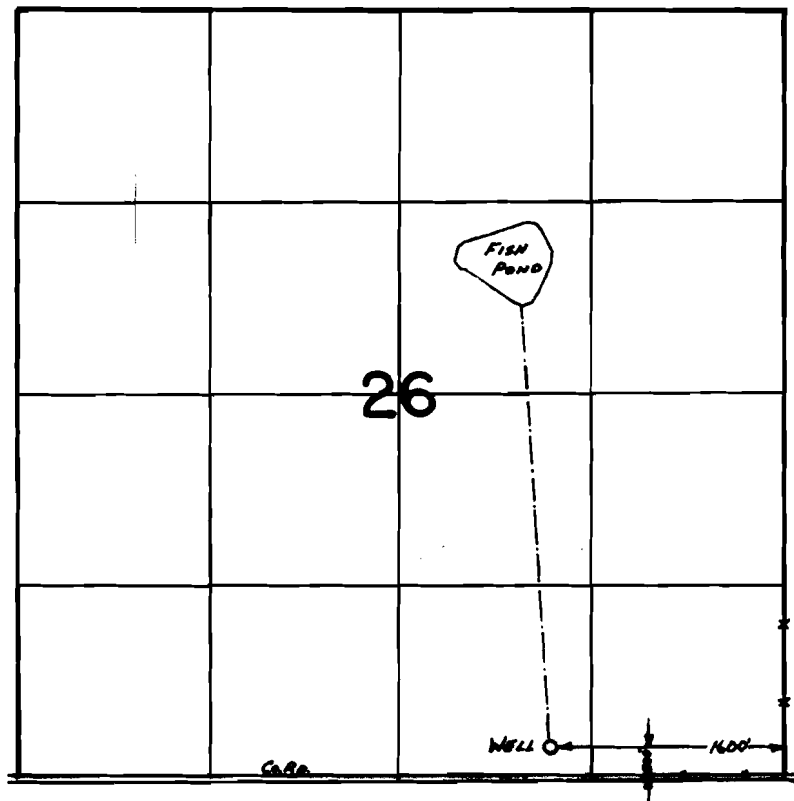

FINAL PROOF SURVEY
UNDER

Application No. G-9901. Permit No. G-9509....
IN NAME OF

BANFIELD VETERINARY HOSPITAL, INC.

Surveyed Oct. 17, 1983, by L.M. TOLL.....