


G9349

52635

T.25S.R.14E.WM

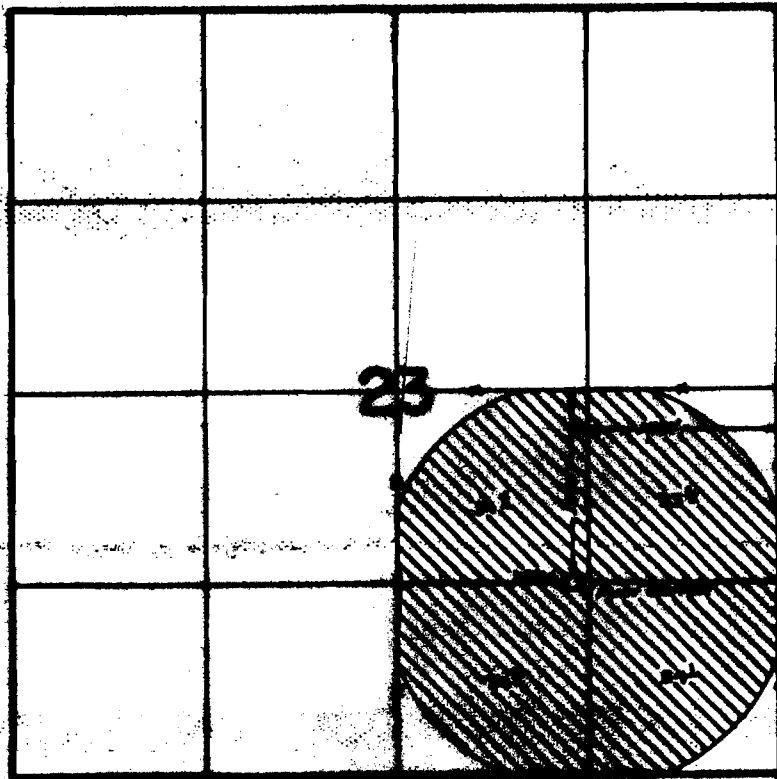

**FINAL PROOF SURVEY
UNDER**

Application No. G-10292 Permit No. G-9349.....

IN NAME OF

JOHN & NORMA FLAMING.....

Surveyed Oct. 19... 19.63., by J. M. TOLL.....