


G 9568
52636

T.27S.,R.17E.,W.M.

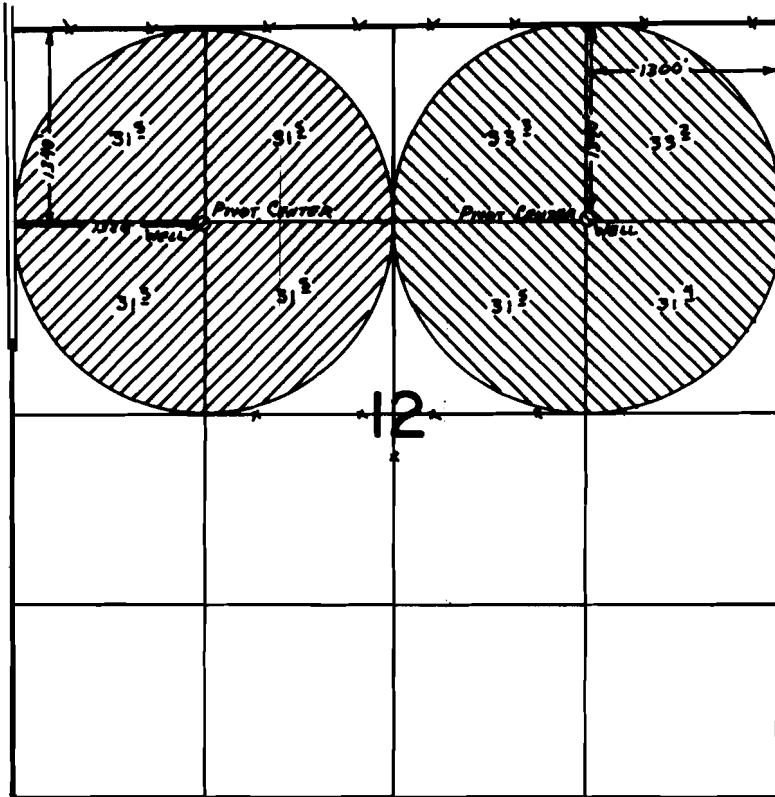

FINAL PROOF SURVEY
UNDER

Application No. G-10211 G-9314
G-10212. Permit No. G-9568. 
IN NAME OF

.....LARRY GRASSMAN.....

Surveyed Oct. 18, 1983, by L. M. TOLL.....