


G 8455
52638

T.27S.,R.16E.,W.M.

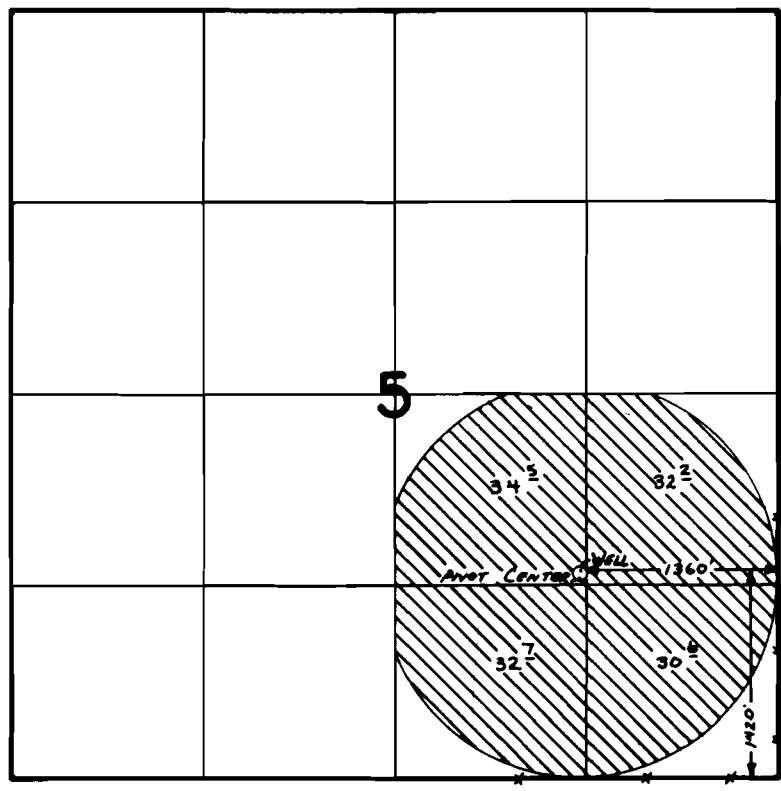

FINAL PROOF SURVEY
UNDER

Application No. G-9038 Permit No. G-8455....
IN NAME OF

GERALD L. & ELVA M. LANIER

Surveyed July 25, 1983, by L.M. TOLL.....

✓