


G 7026
52639

T.27S.,R.22E.,W.M.

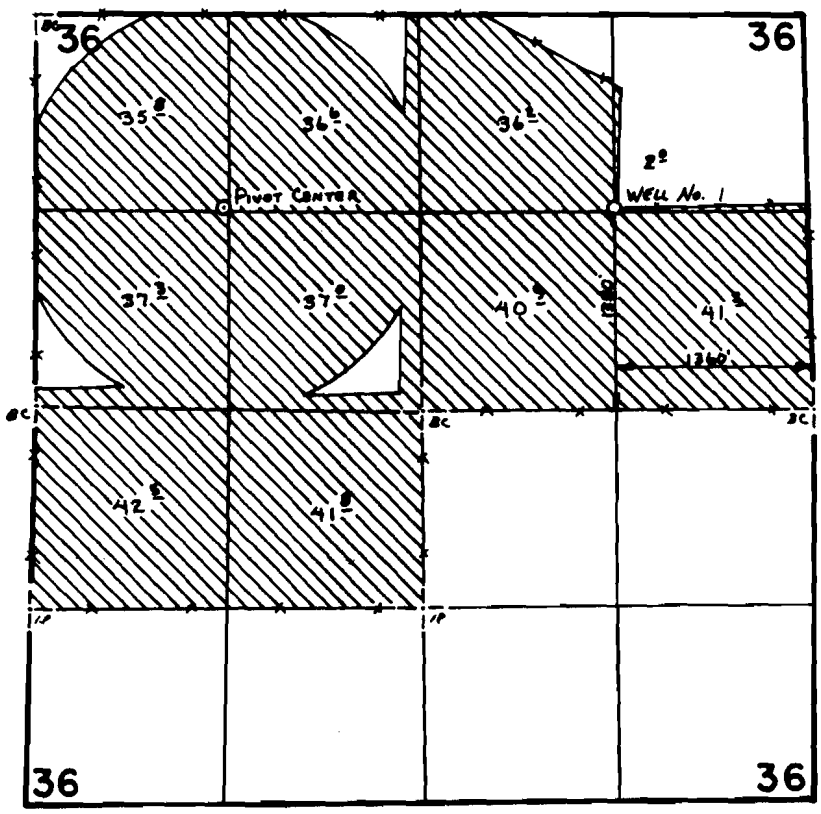

FINAL PROOF SURVEY UNDER

Application No. ..G:7560. Permit No. ..G:7026....
IN NAME OF

.....ROGER...F...CHASE.....

Surveyed July..20.. 19.83., by ..L...M...TOLL.....