


G9651  
52640

# T.27S.,R.16E.,W.M.

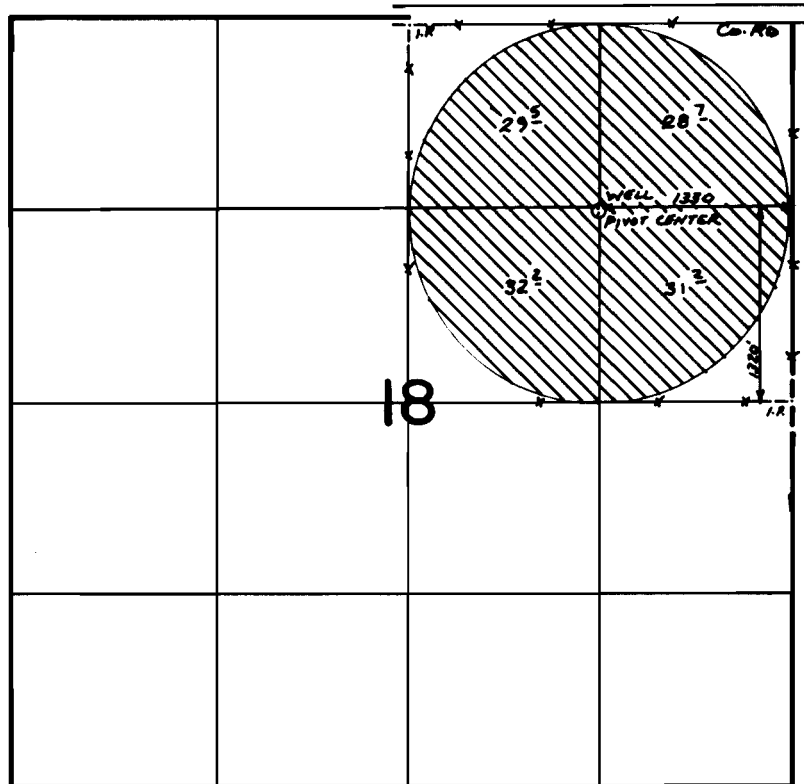

## FINAL PROOF SURVEY UNDER

Application No. G:10680 Permit No. G:9651.....  
IN NAME OF

ROBERT & ARLINE CLINKENBEARD

Surveyed July 25, 1983, by L. M. TOLL.....