


G9230

52642

T.25S.,R.14E.,W.M.

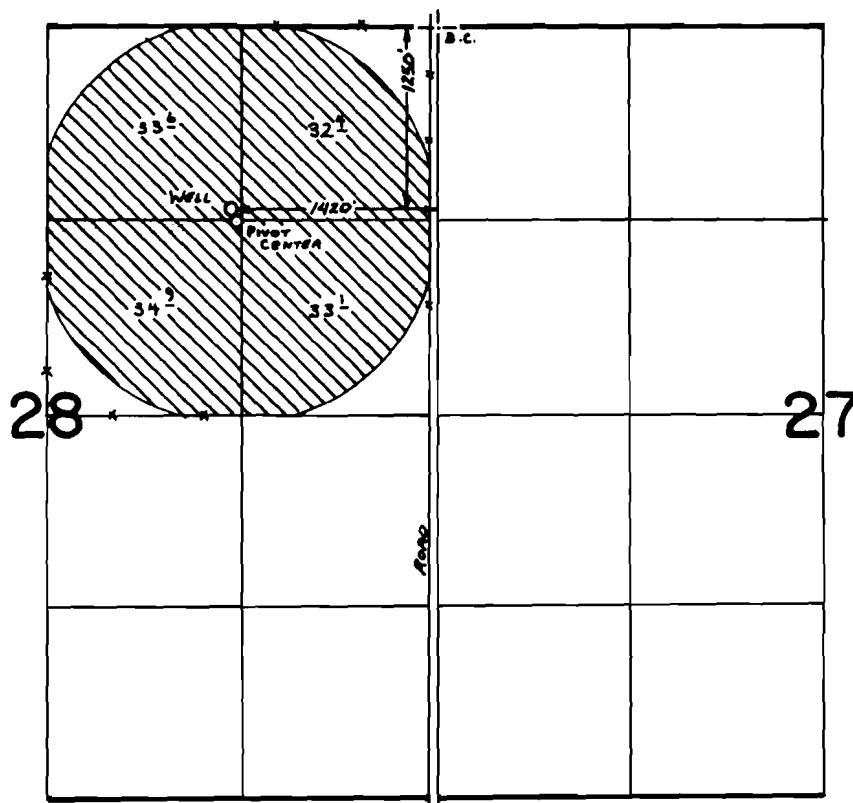

FINAL PROOF SURVEY UNDER

Application No. G:10115.. Permit No. G:9230....
IN NAME OF

.....DAVE PICK.....

Surveyed July..28.. 1983., by J.M.TOLL.....