


G 7269  
52643

T.27S. R.15E. W.M.

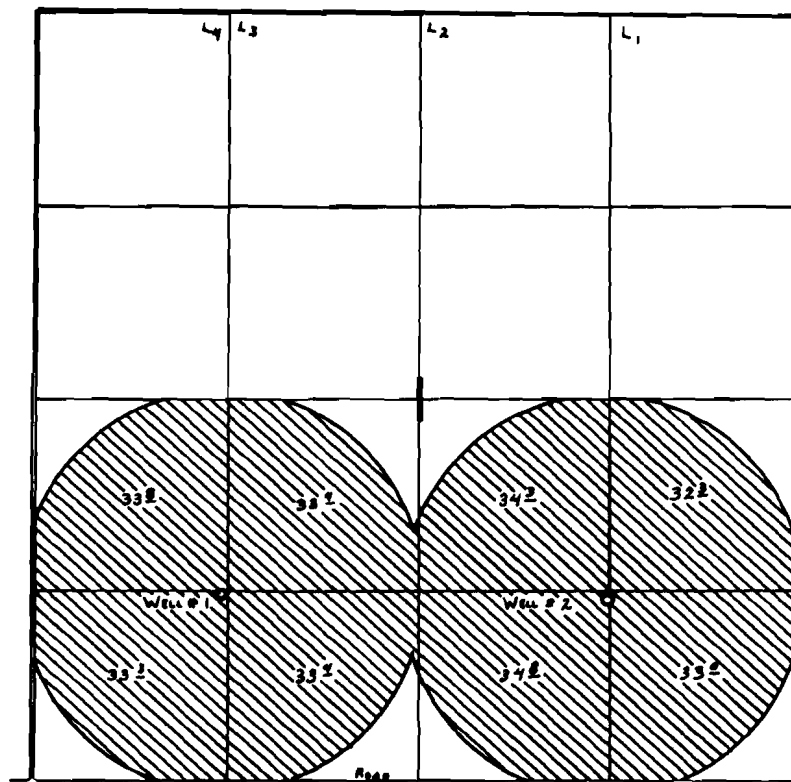

WELLS LOC:  
#1- 1300' N. & 1280' E. } BOTH FROM S.W. COR. SEC. 1.  
#2- 1270' N. & 3950' E. }

**FINAL PROOF SURVEY**  
UNDER

Application No. G-7791, Permit No. G-7269...  
IN NAME OF

.....**HAROLD A. MILES**.....

Surveyed Aug. 28, 1979, by G.L. HUGHES....