


G 7768
52644

T.25S. R.14E. W.M.

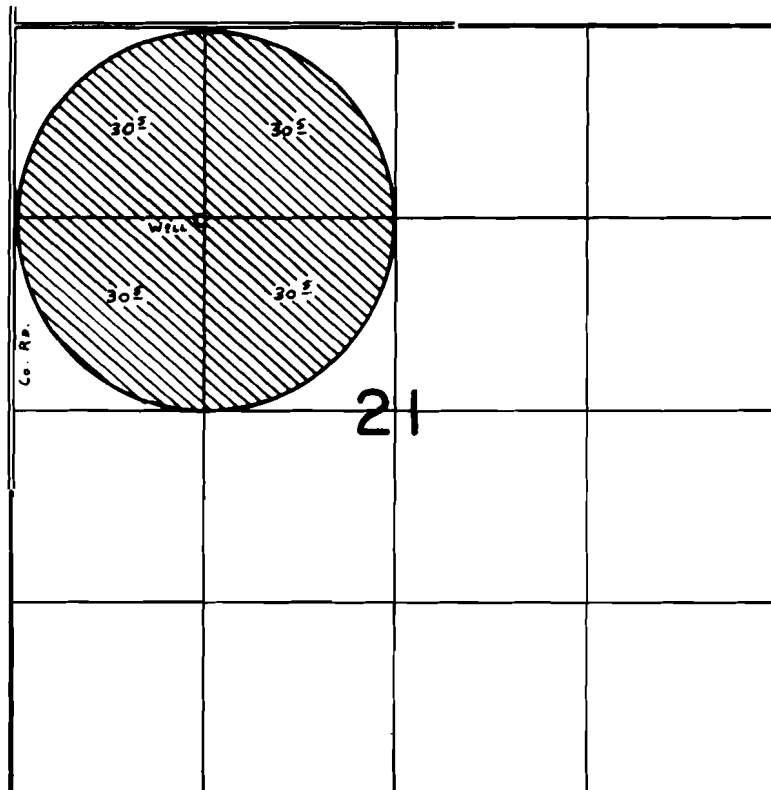

WELL LOC: 1340'S. 1300'E. fr. N.W. COR. SEC. 21.

FINAL PROOF SURVEY
UNDER

Application No. G-8551.. Permit No. G-7768..
IN NAME OF

RALPH H. PIEPGRASS

Surveyed Aug. 30. 1979., by G. L. HUGHES....