


T.27S.,R.13E.,W.M.

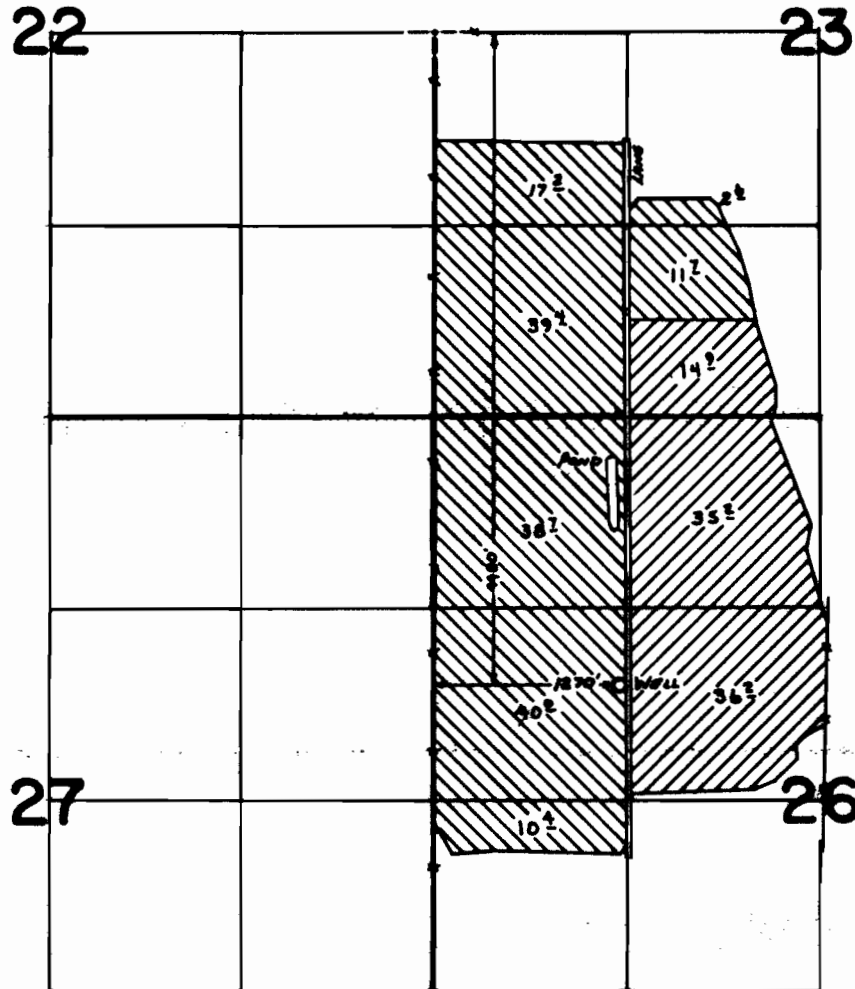

FINAL PROOF SURVEY
UNDER

R-55034 R-6563
G-8253 G-7644
Application No. G-9395 Permit No. G-8652
IN NAME OF



.....PERCY CROFOOT.....

Surveyed July 23, 1983, by L. M. TOLL.....