


T.17S. R.3W. W.M.

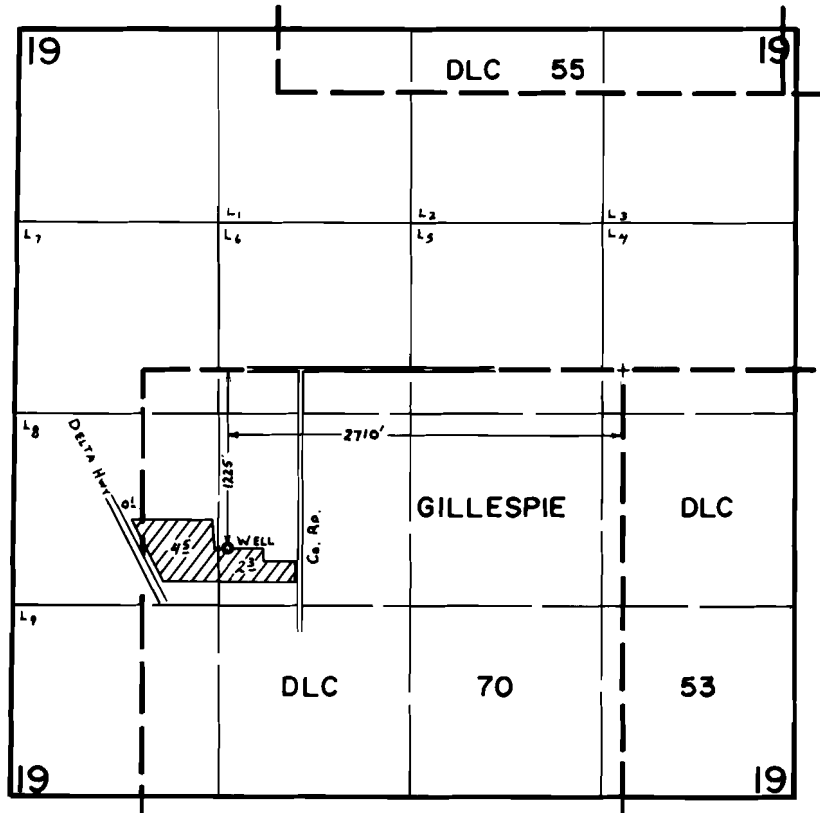

FINAL PROOF SURVEY
UNDER

Application No. G-5275. Permit No. G-4906...
IN NAME OF

..... R. L. & MARTHA GHEEN

Surveyed June 19, 1979, by C. L. HUGHES.....