


T.19S. R.1W. W.M.

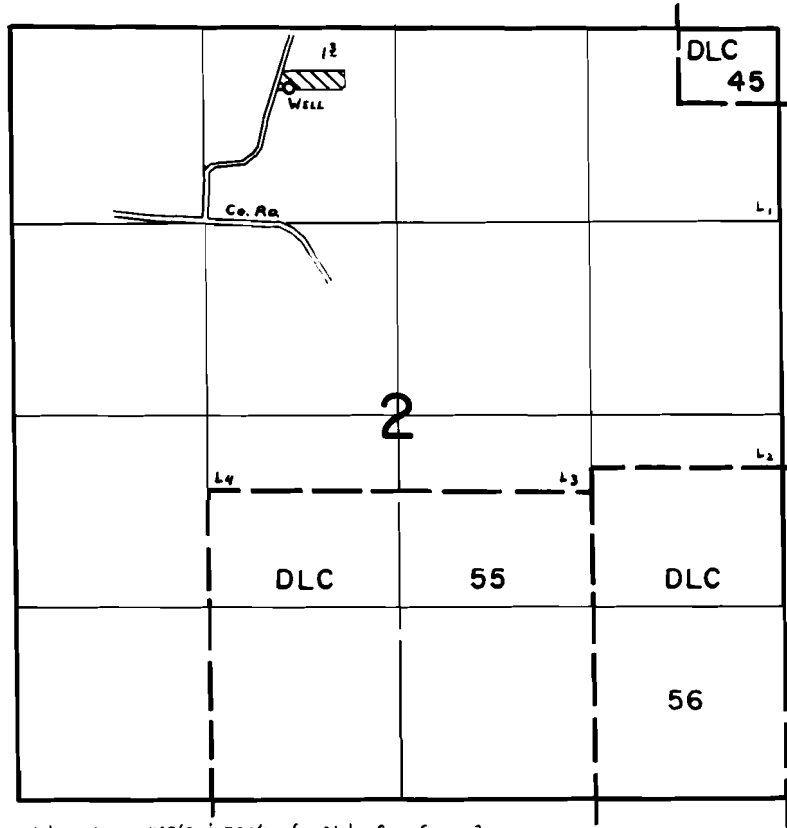

FINAL PROOF SURVEY UNDER

Application No. G-5306. Permit No. G-5134...
IN NAME OF

CAROL & BARRY GILLEY

Surveyed May 25, 1979, by C. L. HUGHES...