


T.16 & 17S. R.2E. W.M.

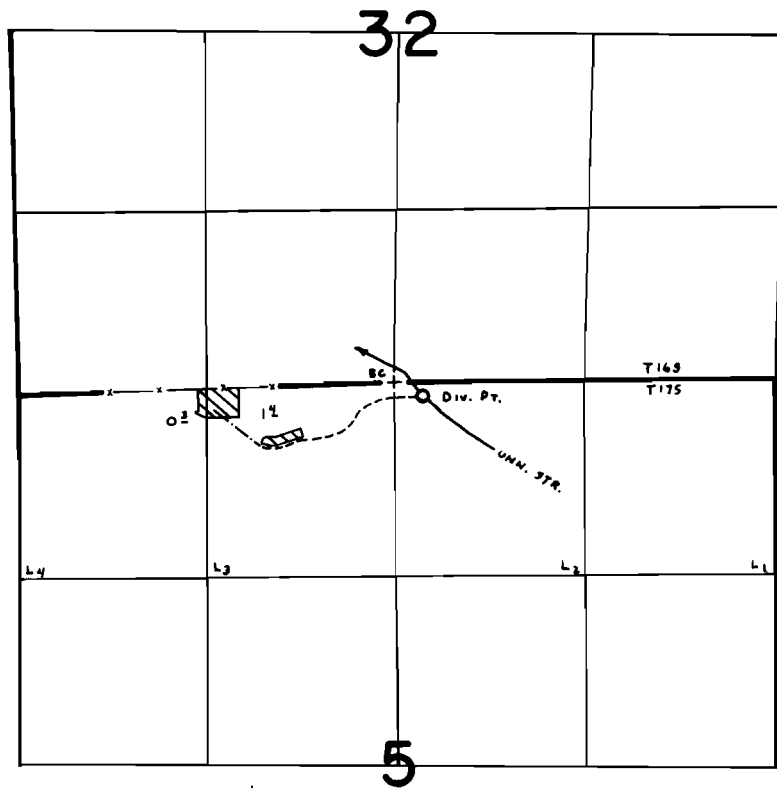

Div. Pt. Loc: 100'S. & 180'E. fr. N. $\frac{1}{4}$ Cor. Sec. 5.

FINAL PROOF SURVEY
UNDER

Application No. 39459 Permit No. 29387.....
IN NAME OF

ALLEN CARUTHERS

Surveyed Sept. 11 1979, by C. L. HUGHES.....