


T.16S.,R.2W.,W.M.

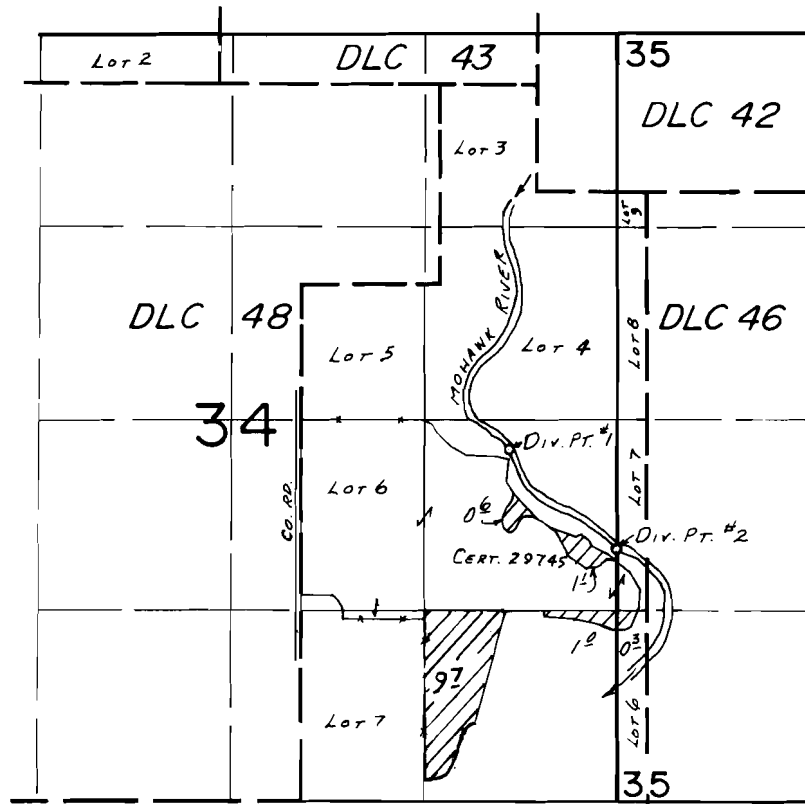

DIV. PTS. LOC. #1-2420'N. & 740'W., #2-1740'N., BOTH FROM THE SE COR. SEC. 34.

FINAL PROOF SURVEY UNDER

Application No. 54107... Permit No. 42835.....
IN NAME OF

MILTON ALLAN CHASE.....

Surveyed SEPT. 13, 1983, by L.M. TOLL.....