


T.20S.,R.5W.,W.M.

Section 20

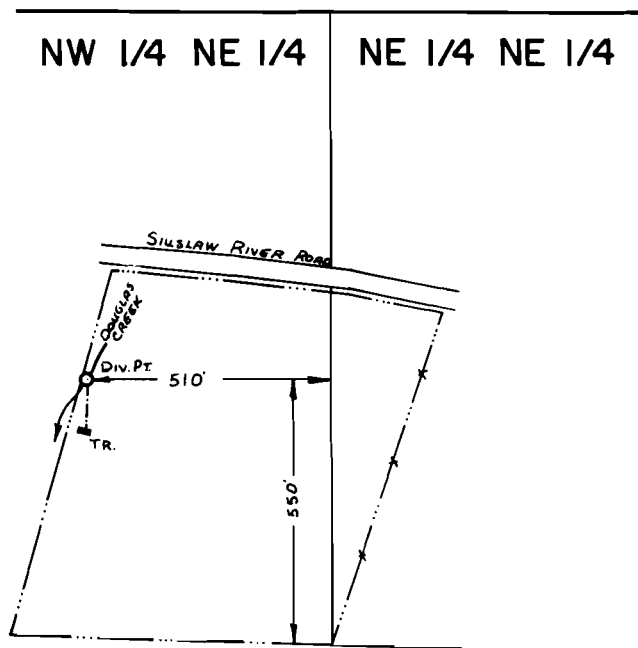

SCALE: 1" = 400'

FINAL PROOF SURVEY
UNDER

Application No. 58836.. Permit No. 44653.....
IN NAME OF

.....DONALD MILLER.....

Surveyed July 13, 1982., by L.M.TOLL.....