


T. 7S. R. 1 & 2W. W.M.

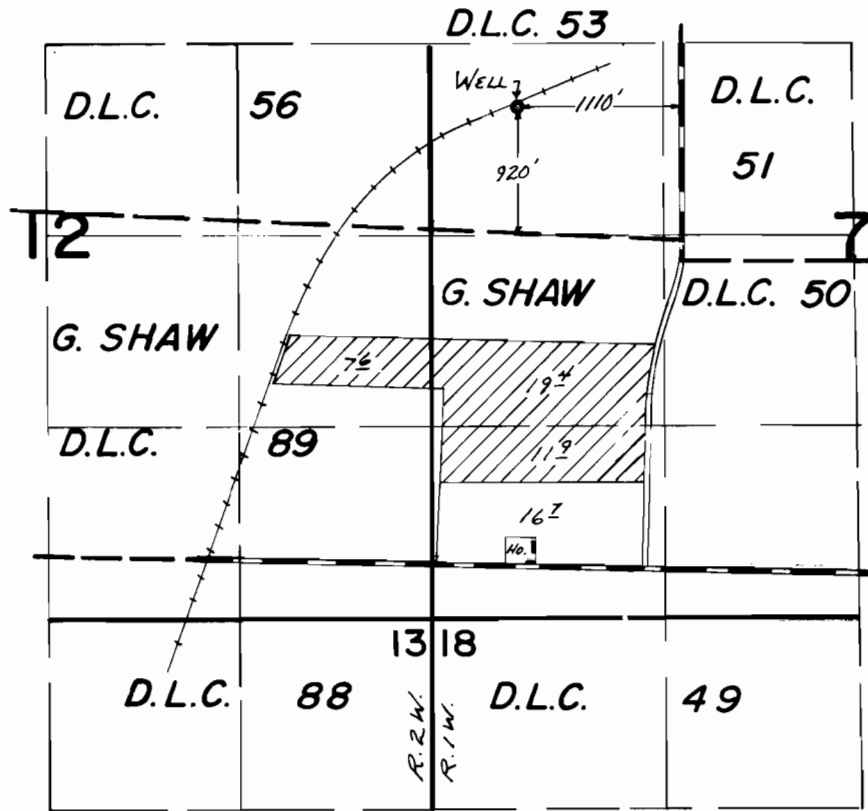

FINAL PROOF SURVEY UNDER

Application No. G-7827 Permit No. G-7221

IN NAME OF
ROBERT E. DETWYLER &
BERNARD T. DETWYLER

Surveyed Sept. 6, 1979, by C.R. RODRIGUEZ