


T.7S. R.1 & 2W. W.M.

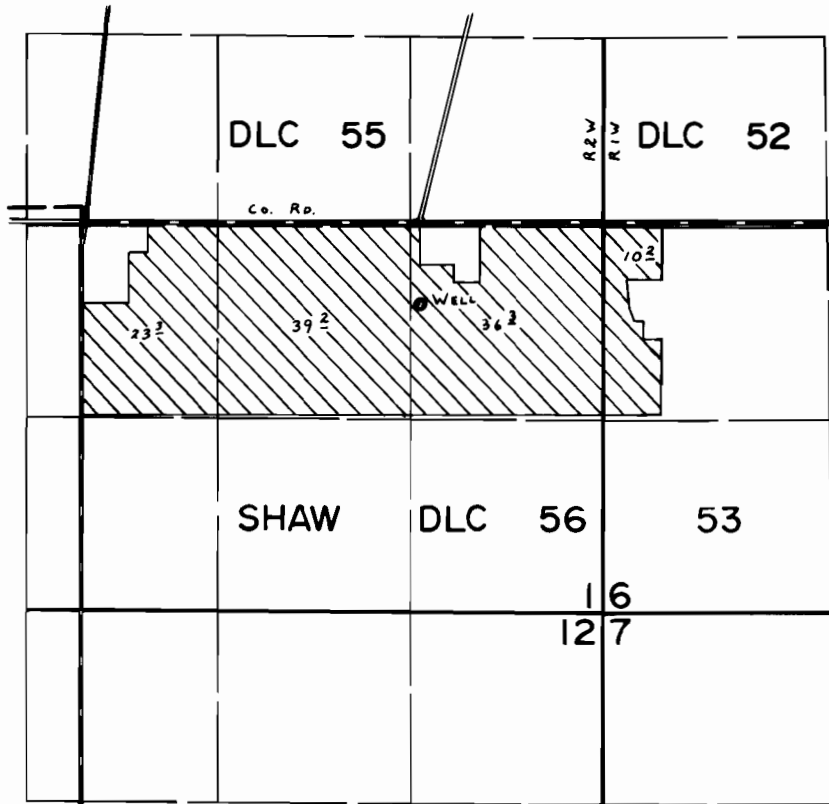

WELL Loc: S60° S. 1/4 2330' E. fr. N.W. COR. SHAW DLC. 56.

FINAL PROOF SURVEY UNDER

Application No. G-9253 Permit No. G-8686
IN NAME OF

KING FARMS

Surveyed June 25, 1980, by C. L. Hughes