


T.6S. R.1W. W.M.

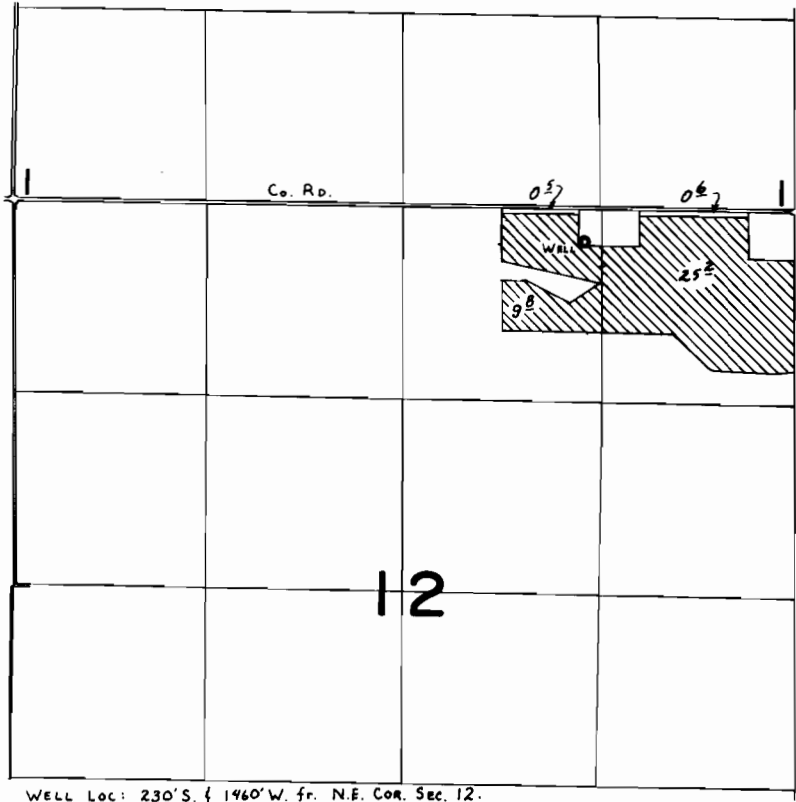

WELL Loc: 230' S. { 1460' W. fr. N.E. Cor. Sec. 12.

FINAL PROOF SURVEY UNDER

Application No. G-9364. Permit No. G-8645.....
IN NAME OF

CHARLES A. RAID

Surveyed July...9... 1980, by ...G. L. Hughes.....