


T. 7 S. R. 2 W. W.M.

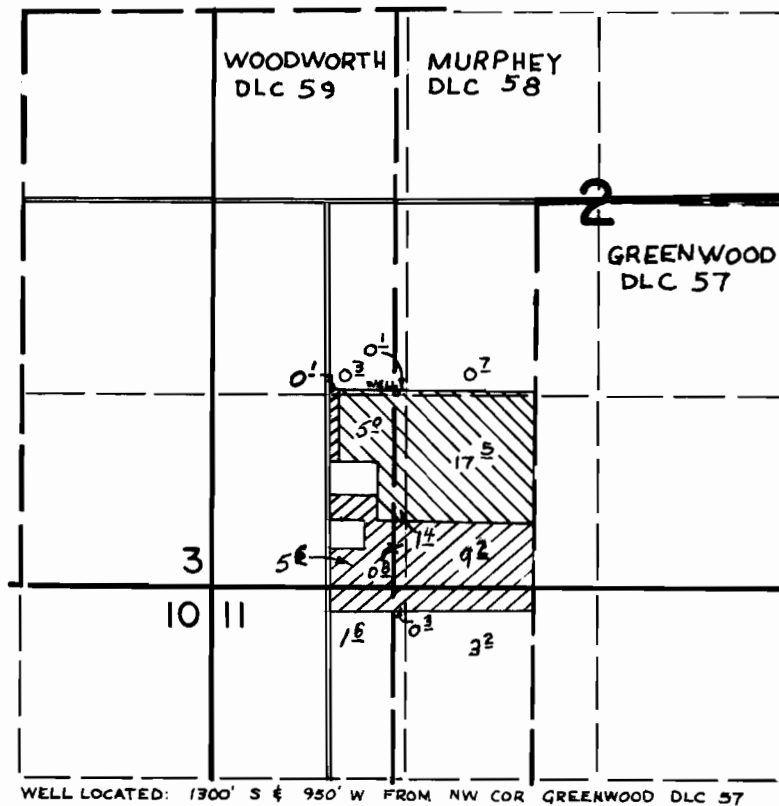

FINAL PROOF SURVEY
UNDER

G-6437 G-5475
Application No. G-4683 Permit No. G-4408
IN NAME OF

ELMER HAURY

Surveyed April 27 1972, by D. Norby
MAY 17 1979 L. H. NUNN