


T.6S.,R.1E.,W.M.

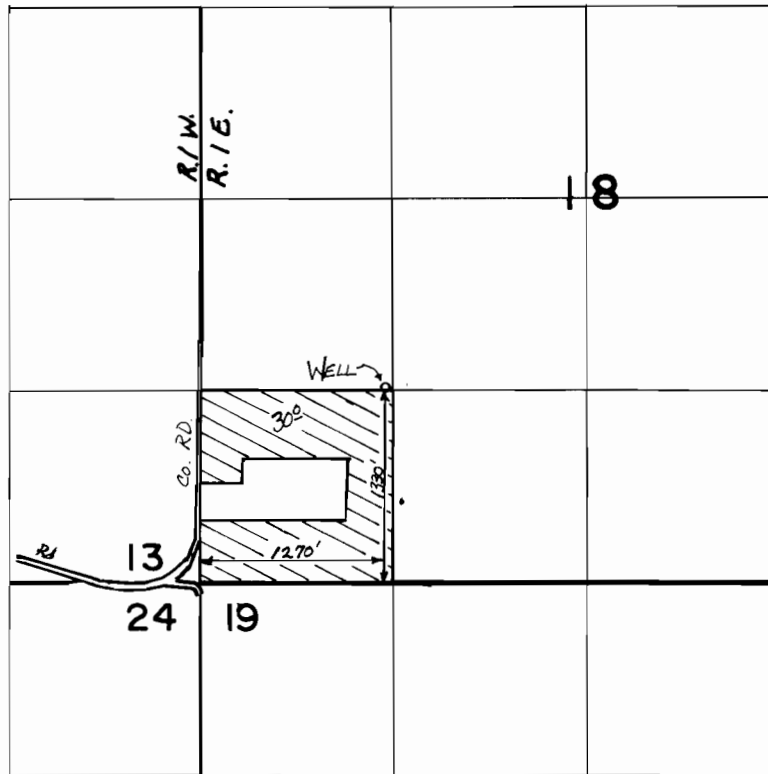

FINAL PROOF SURVEY UNDER

Application No. G.9319.. Permit No. G.8794.....
IN NAME OF

.....**DICKMAN FARMS INC.**.....

Surveyed NOV...8,.... 19.83., by M.CAHILL.....