


T. 3N., R. 27E., W. M.

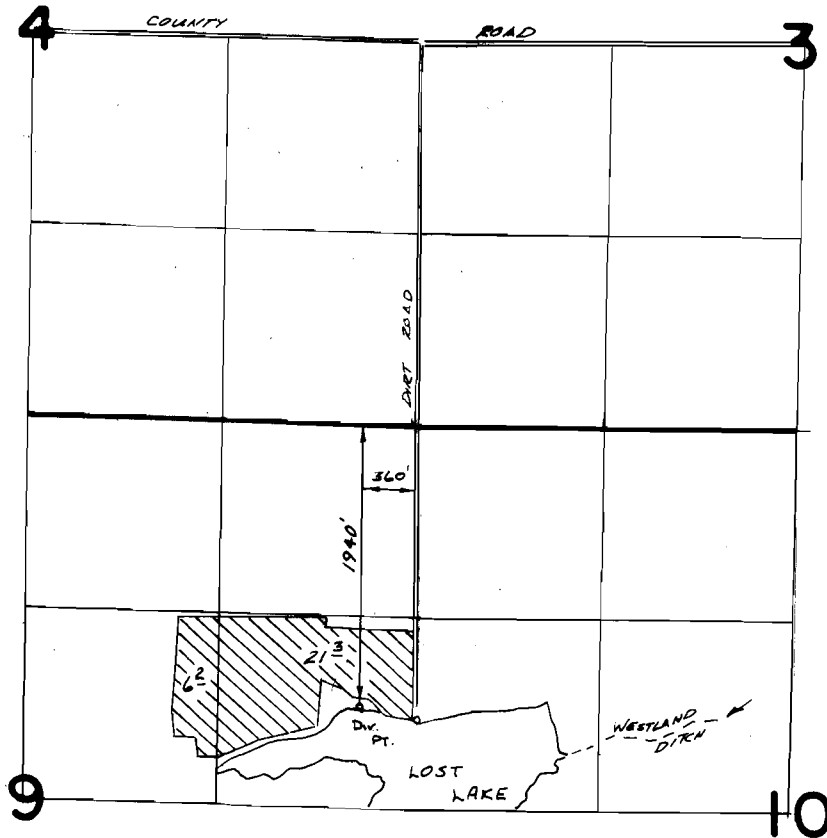

FINAL PROOF SURVEY
UNDER

Application No. **56955**. Permit No. **43652**...
IN NAME OF

.....**WILLIAM HANSELL**.....

Surveyed ~~June 29~~ 1982, by *H. Church*.....