


T. 2S. R. 38E. W.M.

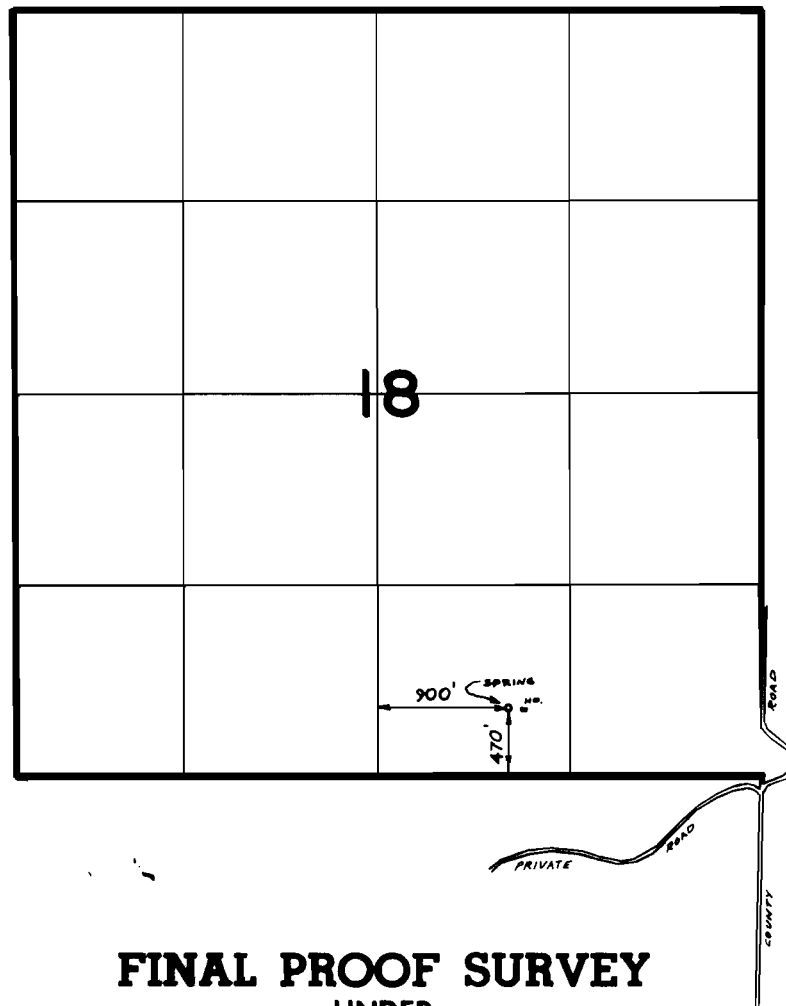

FINAL PROOF SURVEY
UNDER

Application No. **54730** Permit No. **41054**
IN NAME OF

JOSEPH H. WILFORD

Surveyed **10-13** 1977, by **R. BARWIN**