


T. 4N., R. 28E., W. M.

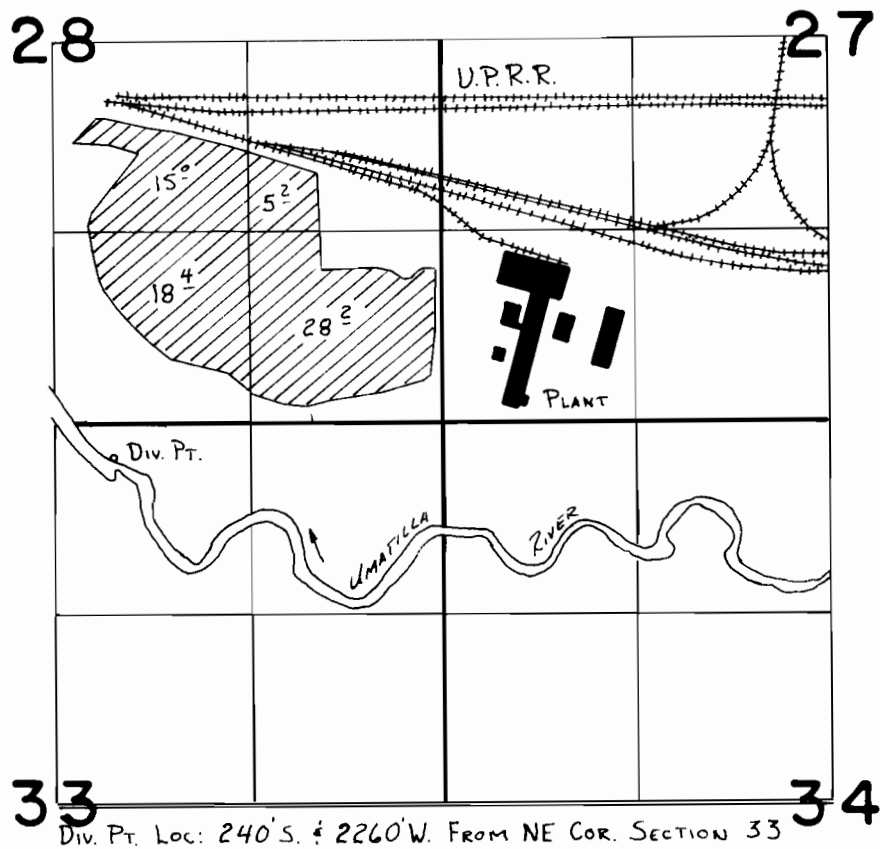

FINAL PROOF SURVEY
UNDER

Application No. **53701**.. Permit No. **39381**.....
IN NAME OF

.....**J.R. SIMPLOT CO.**.....

Surveyed *Jan. 25*..... 19*.84*., by *V.L. Church*.....